


T26S.R5W.W.M.

RECEIVED


OCT 22 1998

1 INCH = 1320 FEET

WATER RESOURCES DEPT.
SALEM, OREGON

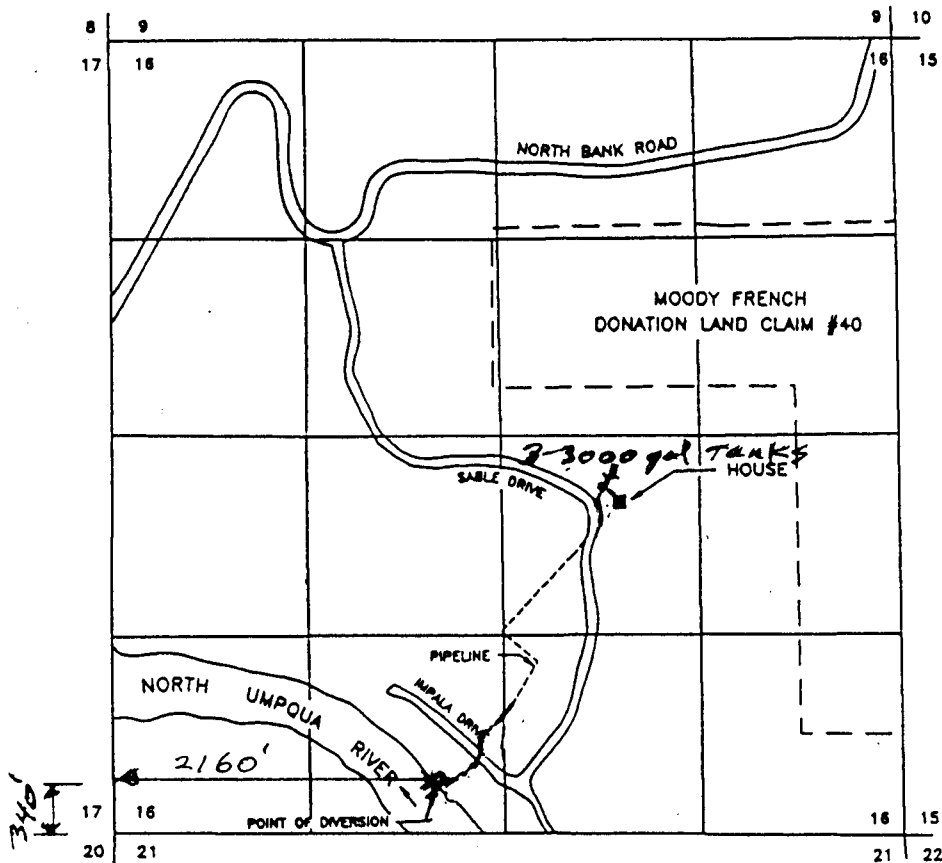

THE PURPOSE OF THIS MAP IS TO IDENTIFY THE LOCATION OF THE WATER RIGHT. IT IS NOT INTENDED TO PROVIDE INFORMATION RELATIVE TO THE LOCATION OF PROPERTY OWNERSHIP BOUNDARY LINES.

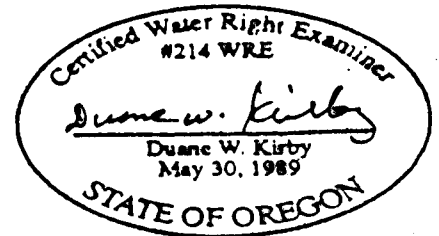

FINAL PROOF SURVEY UNDER

Application No. 73487 Permit No. 52268

IN NAME OF

RUBEN W. & MARY L. HARPER

Surveyed OCT 1, 1998 by DUANE KIRBY