





T. 29 S., R. 5 W., W.M.

RECEIVED

SEP 25 2000

SCALE: 1" = 1320'

WATER RESOURCES DEPT.
SALEM, OREGON

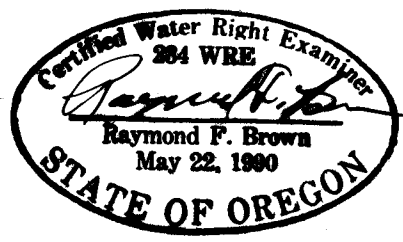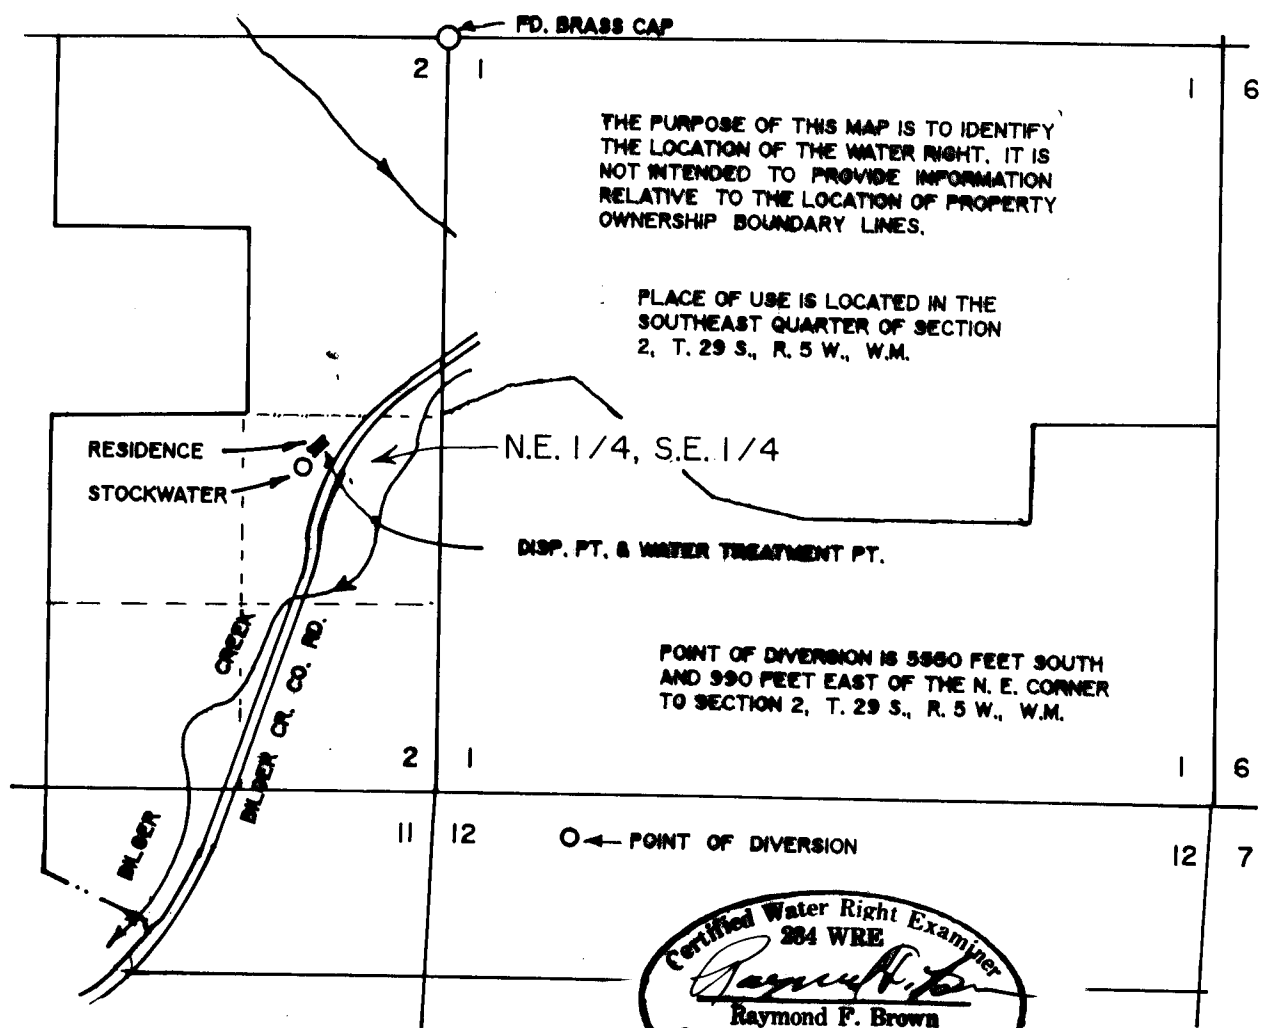

EXF. 12/31/2001

FINAL PROOF SURVEY

UNDER

Application No. S-73859 Permit No. 52971

IN NAME OF

UMPQUA YOUTH INC.

Surveyed: SEPT. 08, 2000 by: R.F. BROWN