



T. 26 S., R. 2 E., W.M.

SCALE: 1" = 400'

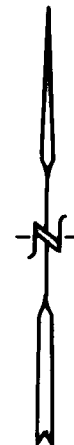

PT. OF DIVERSION NO. 1 IS 49 FEET
NORTH & 987 FEET WEST OF COR.
NO. 1 OF HOMESTEAD ENTER SURVEY
NO. 93.

PT. OF DIVERSION NO. 2 IS 18 FEET
NORTH AND 1004 FEET WEST OF
CORNER NO. 1 OF HOMESTEAD ENTER
SURVEY NO. 93.

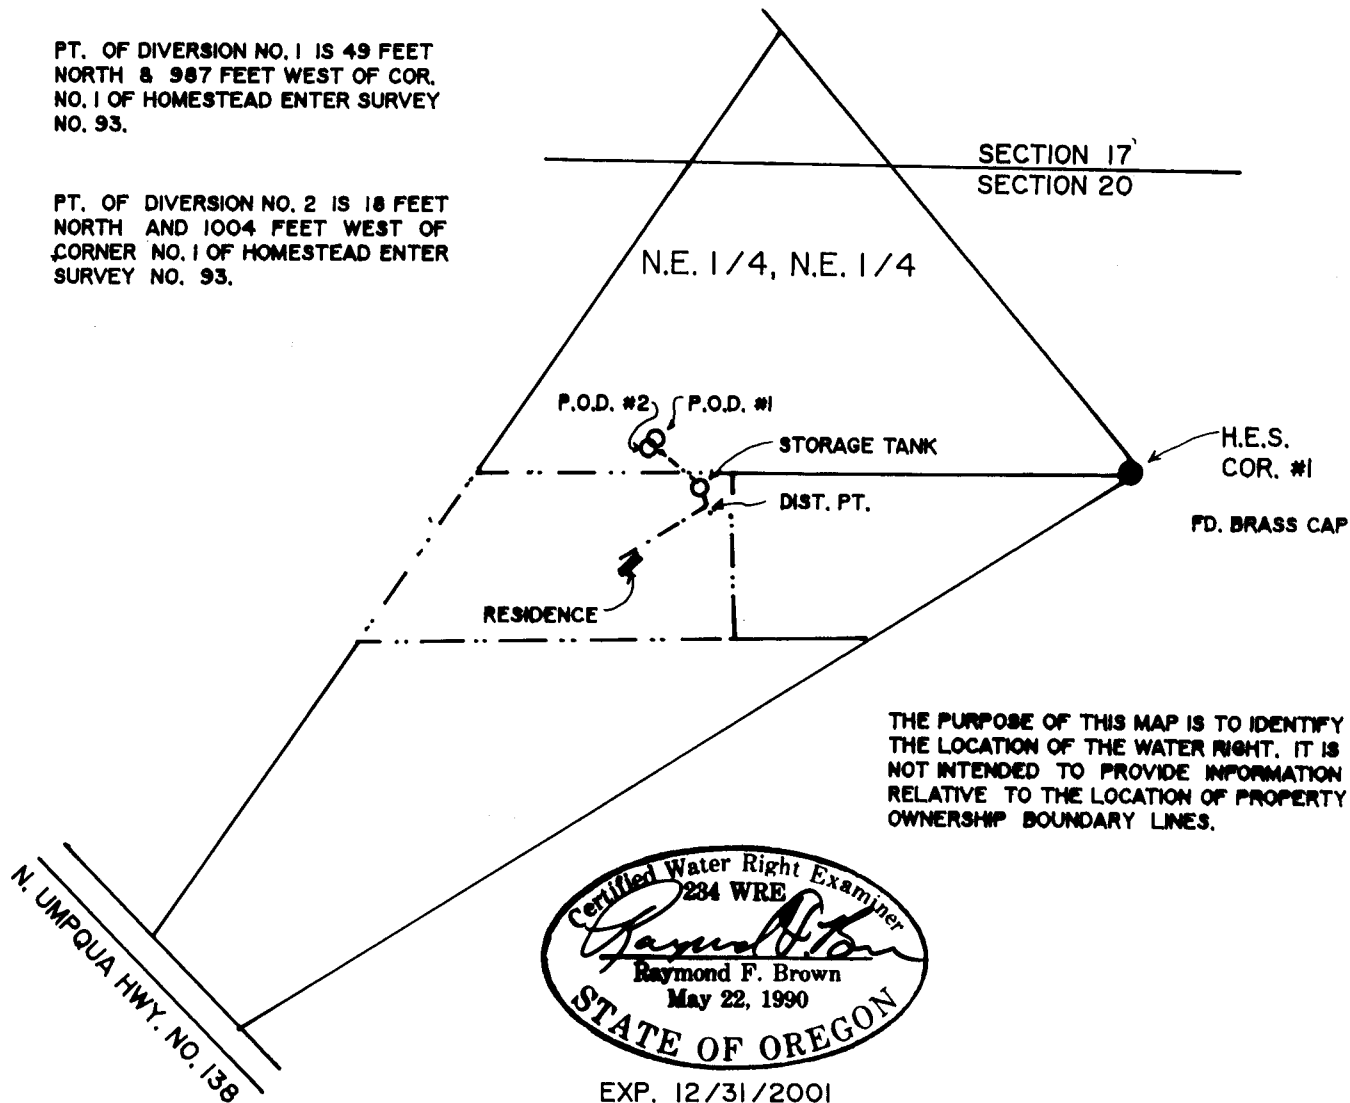

THE PURPOSE OF THIS MAP IS TO IDENTIFY
THE LOCATION OF THE WATER RIGHT. IT IS
NOT INTENDED TO PROVIDE INFORMATION
RELATIVE TO THE LOCATION OF PROPERTY
OWNERSHIP BOUNDARY LINES.



EXP. 12/31/2001

FINAL PROOF SURVEY

UNDER

Application No. S-74224 Permit No. 52608

IN NAME OF

STANLEY D. HAYS

RECEIVED

SEP 26 2000

**WATER RESOURCES DEPT.
SALEM, OREGON**

Surveyed: AUG. 27, 2000 by: R.F. BROWN