

T. 26 S., R. 2 E., W.M.

SCALE: 1" = 400'

POINT OF DIVERSION NO. 1 IS 49 FEET
NORTH & 987 FEET WEST OF COR. NO. 1
OF HOMESTEAD ENTER SURVEY NO. 93.

POINT OF DIVERSION NO. 2 IS 18 FEET
NORTH & 1004 FEET WEST OF COR. NO. 1
OF HOMESTEAD ENTER SURVEY NO. 93.

SECTION 17
SECTION 20

N.E. 1/4, N.E. 1/4

P.O.D. #2

- P.O.D. #1

STORAGE TANK

- DIST. PT.

← SHOP


**-LAWN AND
GARDEN AREA**

RESIDENCE

H. E. S.
COR. #1

FD. BRASS CAP

THE PURPOSE OF THIS MAP IS TO IDENTIFY THE LOCATION OF THE WATER RIGHT. IT IS NOT INTENDED TO PROVIDE INFORMATION RELATIVE TO THE LOCATION OF PROPERTY OWNERSHIP BOUNDARY LINES.

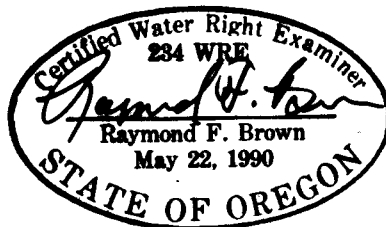

EXP. 12/31/2001

FINAL PROOF SURVEY

UNDER

Application No. S-74482 Permit No. 52605

IN NAME OF

TODD O. & CYNTHIA S. WEEKLY

Surveyed: AUG. 27, 2000 by: R.F. BROWN

RECEIVED

SEP 25 2000

WATER RESOURCES DEPT.
SALEM, OREGON