

RECEIVED


MAY 19 1998

WATER RESOURCES DEPT.
SALEM, OREGON

T26S, R5W, WM

SCALE 1" = 1320'

DOUGLAS COUNTY

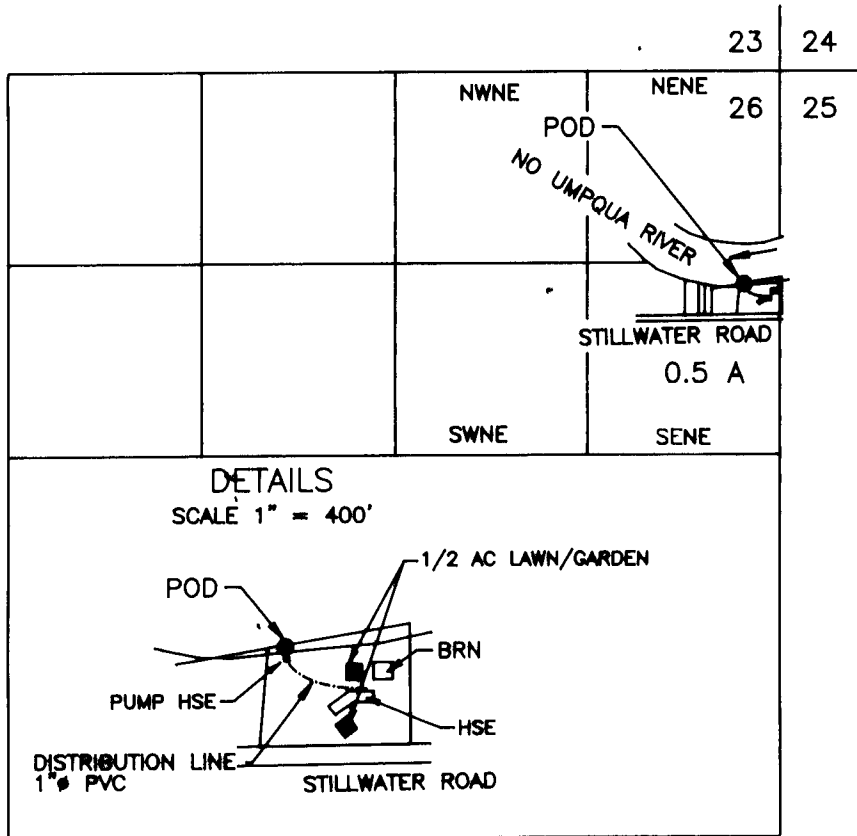

POD IS 1175 FT N AND 250 FT W FROM E 1/4 COR, SEC 26

FINAL PROOF SURVEY UNDER

Application No. S-74684 Permit No. 52569

IN NAME OF

RICHARD L BROCK and DOROTHY C. BROCK

Surveyed January 15, 1998 by M E Farr

MAURICE E FARR
1960 SW BURDETTE DR
ROSEBURG, OR 97470

THIS IS A LOCATION MAP FOR A FINAL PROOF SURVEY BY RICHARD L AND DOROTHY C BROCK. THIS MAP IS FOR THE PURPOSE OF IDENTIFYING THE LOCATION OF THE WATER RIGHT ONLY AND IS NOT INTENDED TO PROVIDE LEGAL DIMENSIONS OR LOCATIONS OF PROPERTY OWNERSHIP LINES.

