

FINAL PROOF SURVEY
FOR
BIG CREEK DITCH CO. LANDS
UNDER

PERMITS NUMBERS 30974 & 30975

By
BAGETT, GRIFFITH & BLACKMAN
2006 ADAMS AVENUE
LAGRANDE, OREGON, 97850

MARCH 11, 1996, REVISED 2-04-2002


Application Number 41384 & 41385

Permit Number 30974 & 30975

T 6 S R 41 E
T 7 S R 41 E


RANGE 41 EAST
RANGE 42 EAST

T 7 S R 41 E

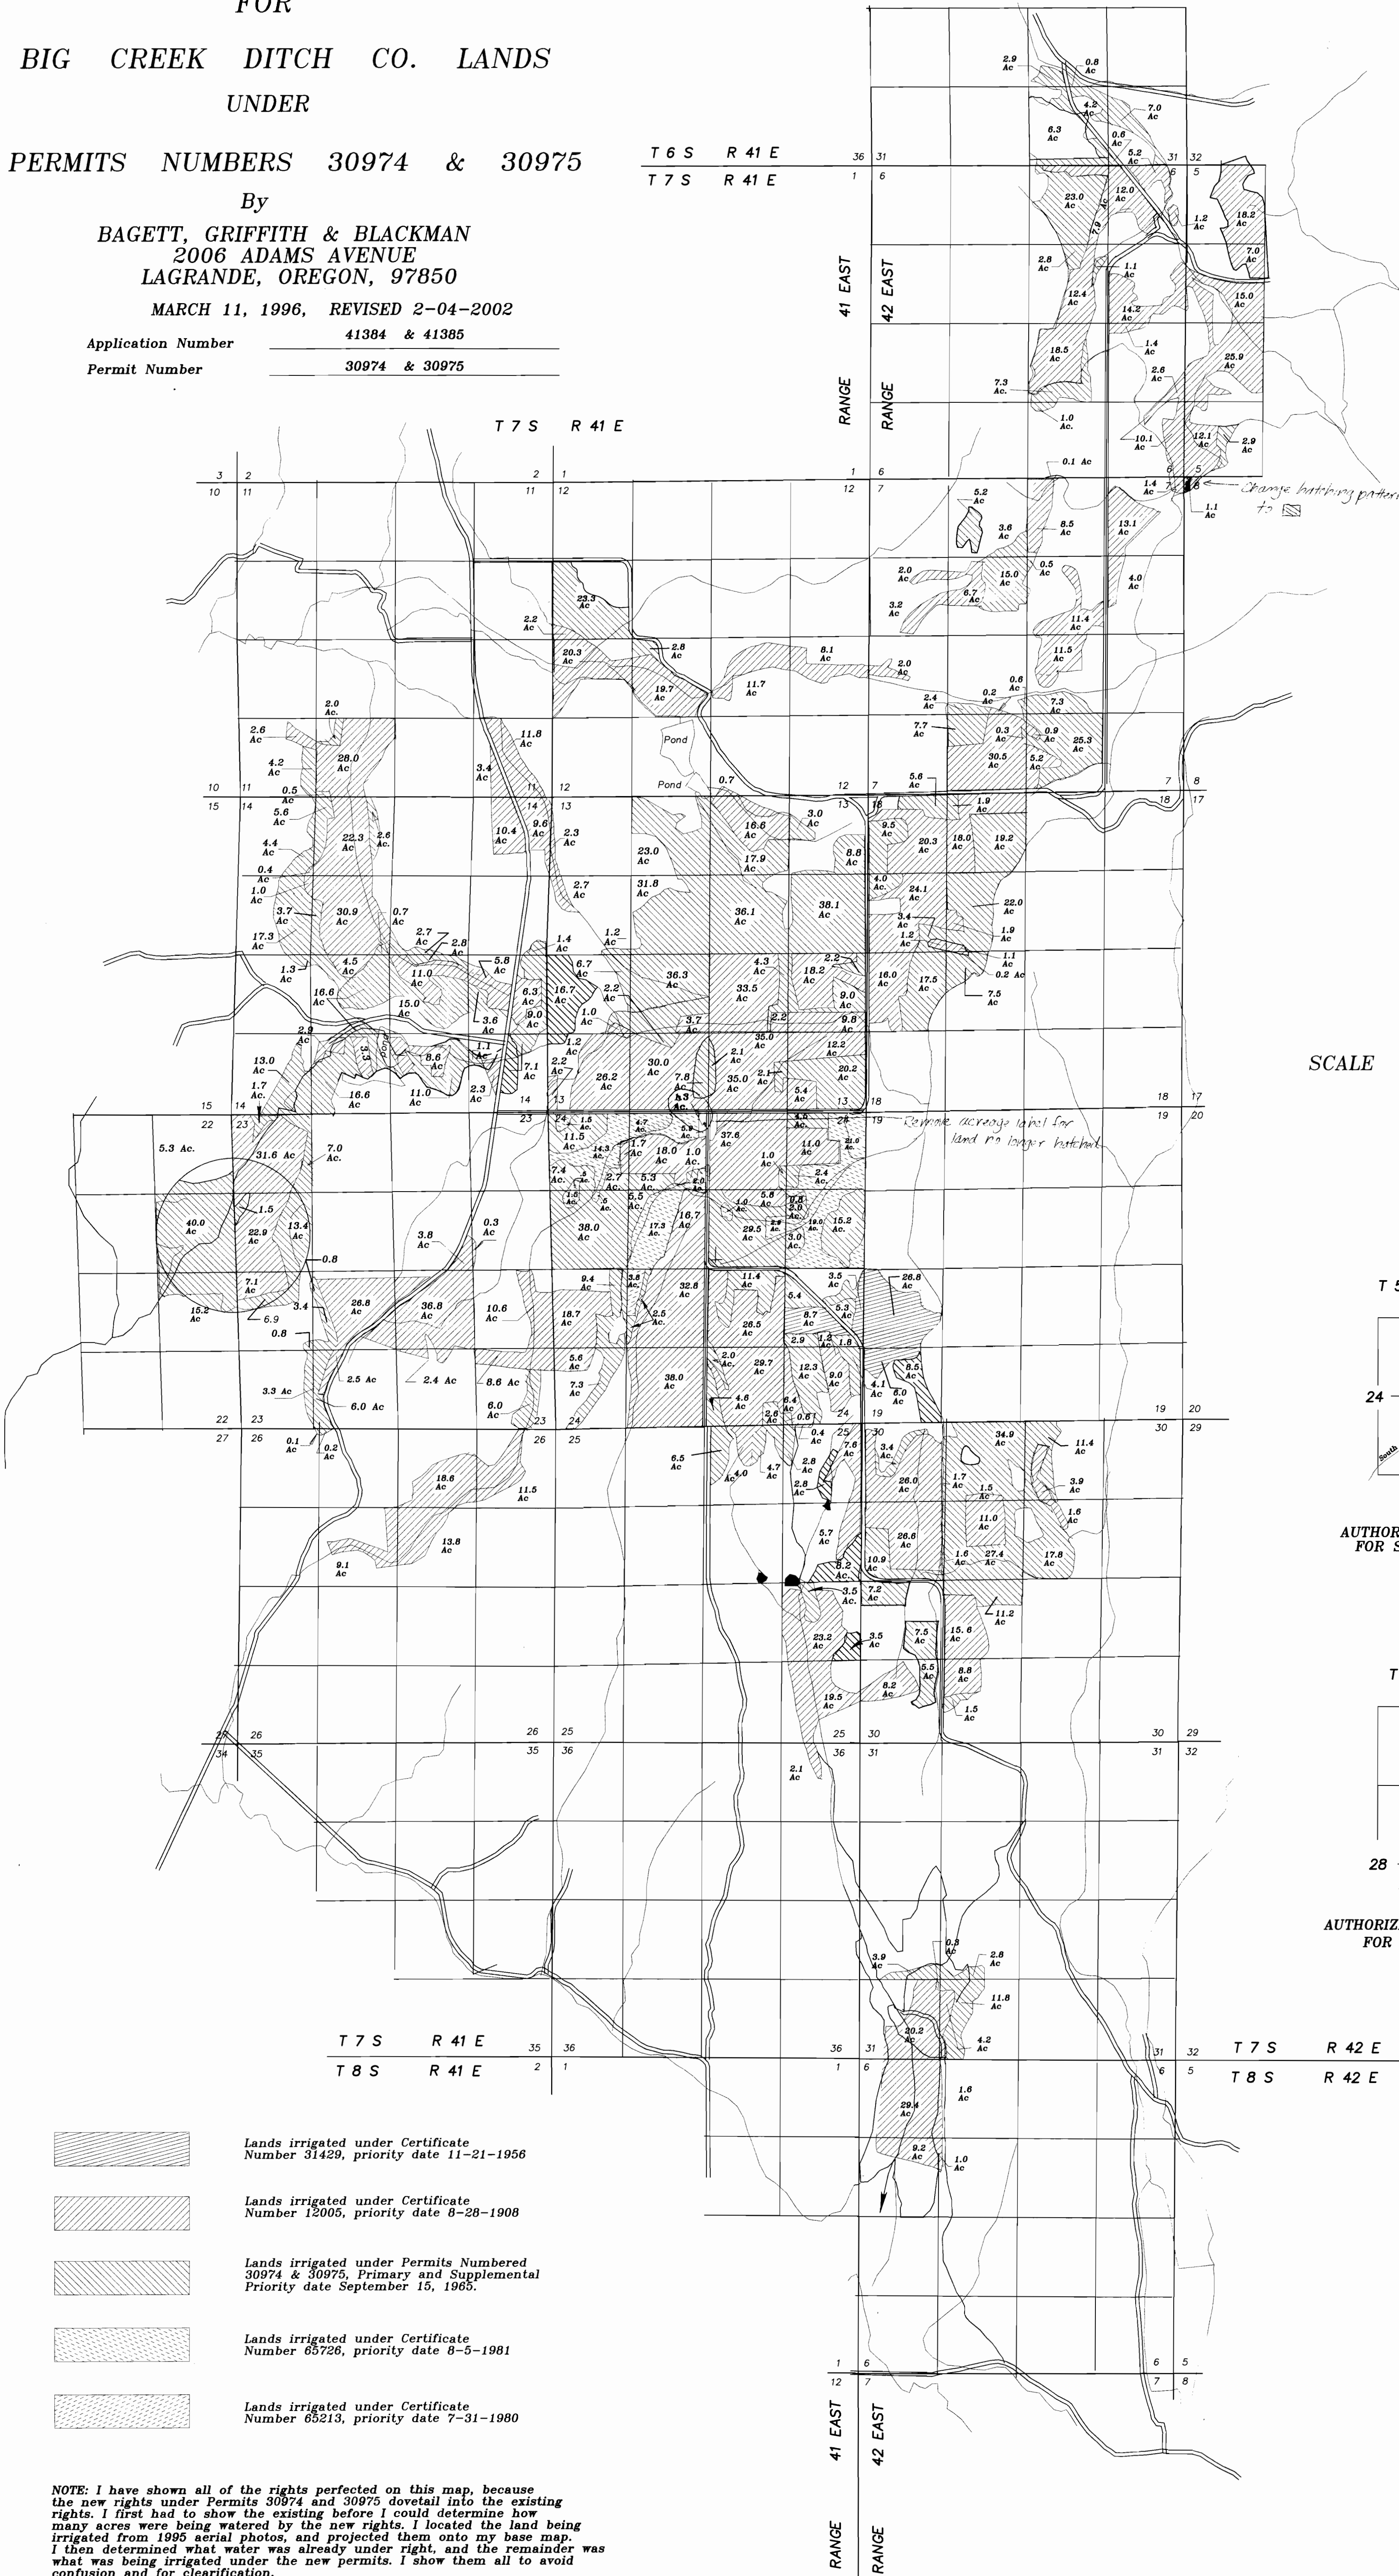


SCALE 1" = 1320'

T 5 S R 42 E

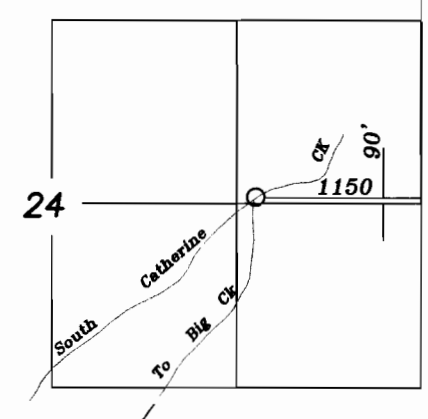

AUTHORIZED POINT OF DIVERSION
FOR SOUTH CATHERINE DITCH



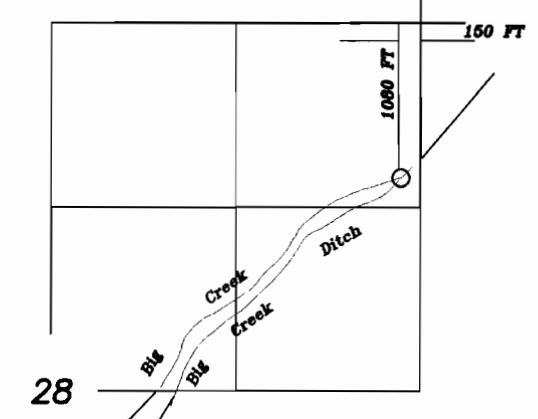


T 6 S R 42 E




AUTHORIZED POINT OF DIVERSION
FOR BIG CREEK DITCH

T 7 S R 41 E
T 8 S R 41 E

T 7 S R 42 E
T 8 S R 42 E

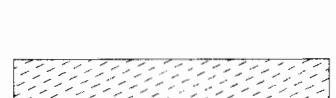-  Lands irrigated under Certificate Number 31429, priority date 11-21-1956
-  Lands irrigated under Certificate Number 12005, priority date 8-28-1908
-  Lands irrigated under Permits Numbered 30974 & 30975, Primary and Supplemental Priority date September 15, 1965.
-  Lands irrigated under Certificate Number 65726, priority date 8-5-1981
-  Lands irrigated under Certificate Number 65213, priority date 7-31-1980

NOTE: I have shown all of the rights perfected on this map, because the new rights under Permits 30974 and 30975 dovetail into the existing rights. I first had to show the existing before I could determine how many acres were being watered by the new rights. I located the land being irrigated from 1995 aerial photos, and projected them onto my base map. I then determined what water was already under right, and the remainder was what was being irrigated under the new permits. I show them all to avoid confusion and for clarification.

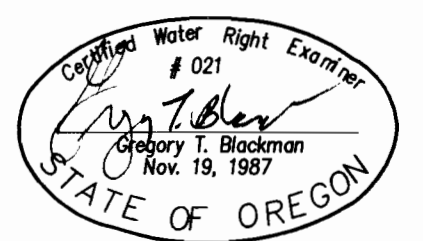

NOTE: The preparation of this map was for the purpose of identifying the location of the proposed water right and has no intent to provide a means of location of property ownership lines. Location information shown hereon was furnished by the applicant.

RECEIVED
FEB 04 2006
WATER RESOURCES DEPT
SALEM, OREGON


