


CLAIM OF BENEFICIAL USE
 SURVEYED MARCH 5, 2001
 BY DUANE W. KIRBY
 FOR LONNIE LEONARD
 APPLICATION NO. 72103
 PERMIT NO. 52178
 T25S R8W WM
 SECTION 36
 TAXLOT 700

RECEIVED
 OCT 30 2001
 WATER RESOURCES DEPT.
 SALEM, OREGON

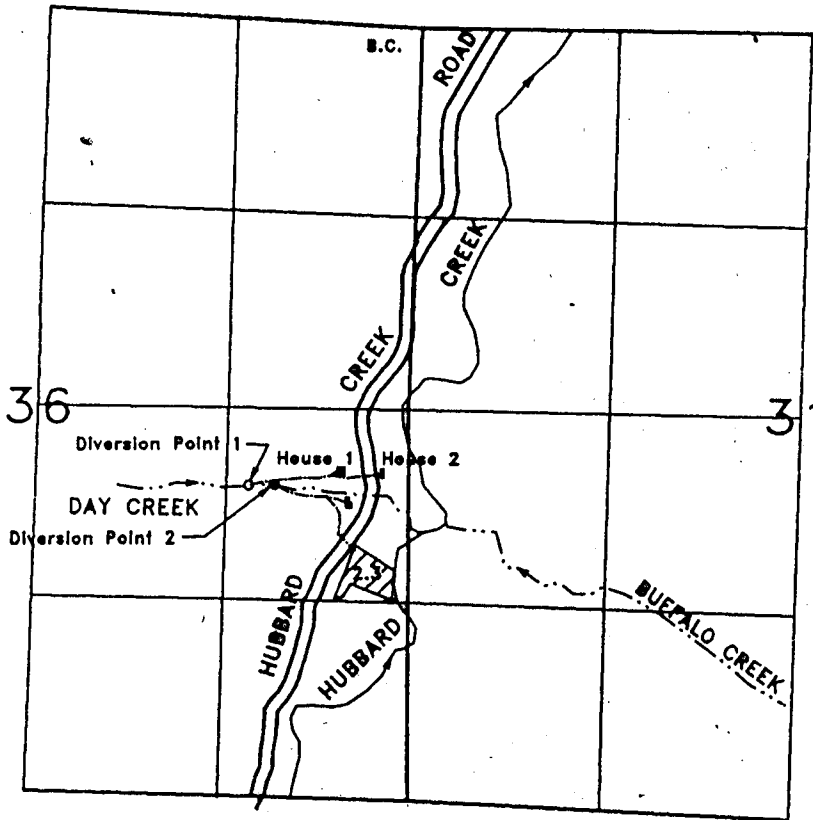

SCALE:
 1"=1320'

DIVERSION POINT 1 IS LOCATED 3180 FEET SOUTH AND 1180 FEET WEST FROM THE NORTHEAST CORNER OF SECTION 36.

DIVERSION POINT 2 IS LOCATED 3170 FEET SOUTH AND 1030 FEET WEST FROM THE NORTHEAST CORNER OF SECTION 36.

THE PURPOSE OF THIS MAP IS TO IDENTIFY THE LOCATION OF THE WATER RIGHT. IT IS NOT INTENDED TO PROVIDE INFORMATION RELATIVE TO THE LOCATION OF PROPERTY OWNERSHIP BOUNDARY LINES.

