


Scale: 1" = 400 ft.

Point of Diversion is 170 ft. South and 250 ft. West of the east 1/4 corner Section 19, T 26 S, R 5 W, W. M.

**RECEIVED**  
 FEB 09 1999  
 WATER RESOURCES DEPT.  
 SALEM, OREGON

**FINAL PROOF SURVEY OF A  
 PERMIT TO APPROPRIATE SURFACE WATER  
 FROM THE CALVIN C. REED D.L.C. NO. 47  
 & THE NE 1/4 SE 1/4 OF SECTION 19, T 26 S,  
 R 5 W, W. M., DOUGLAS COUNTY, OREGON**

Application No. S-72109  
 Permit No. 51625

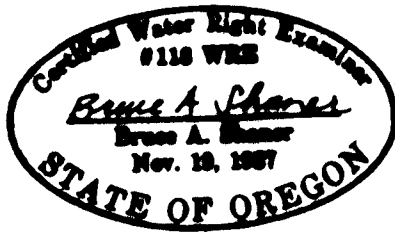

For: Stephen K. Stanton  
 P. O. Box 586  
 Winchester, Oregon 97495  
 By: Shaner Engineering, Inc.  
 P. O. Box 1430  
 Roseburg, Oregon 97470

February 9, 1999