

RECEIVED

CLAIM OF BENEFICIAL USE

JUL 27 1999

APPLICATION NO. 72143


PERMIT NO. 51809

WATER RESOURCES DEPT.
SALEM, OREGON

FOR: DARRELL K. MARSTERS

SURVEYED JULY 17 1999, BY DUANE W. KIRBY

T.26S.,R.5W.W.M.

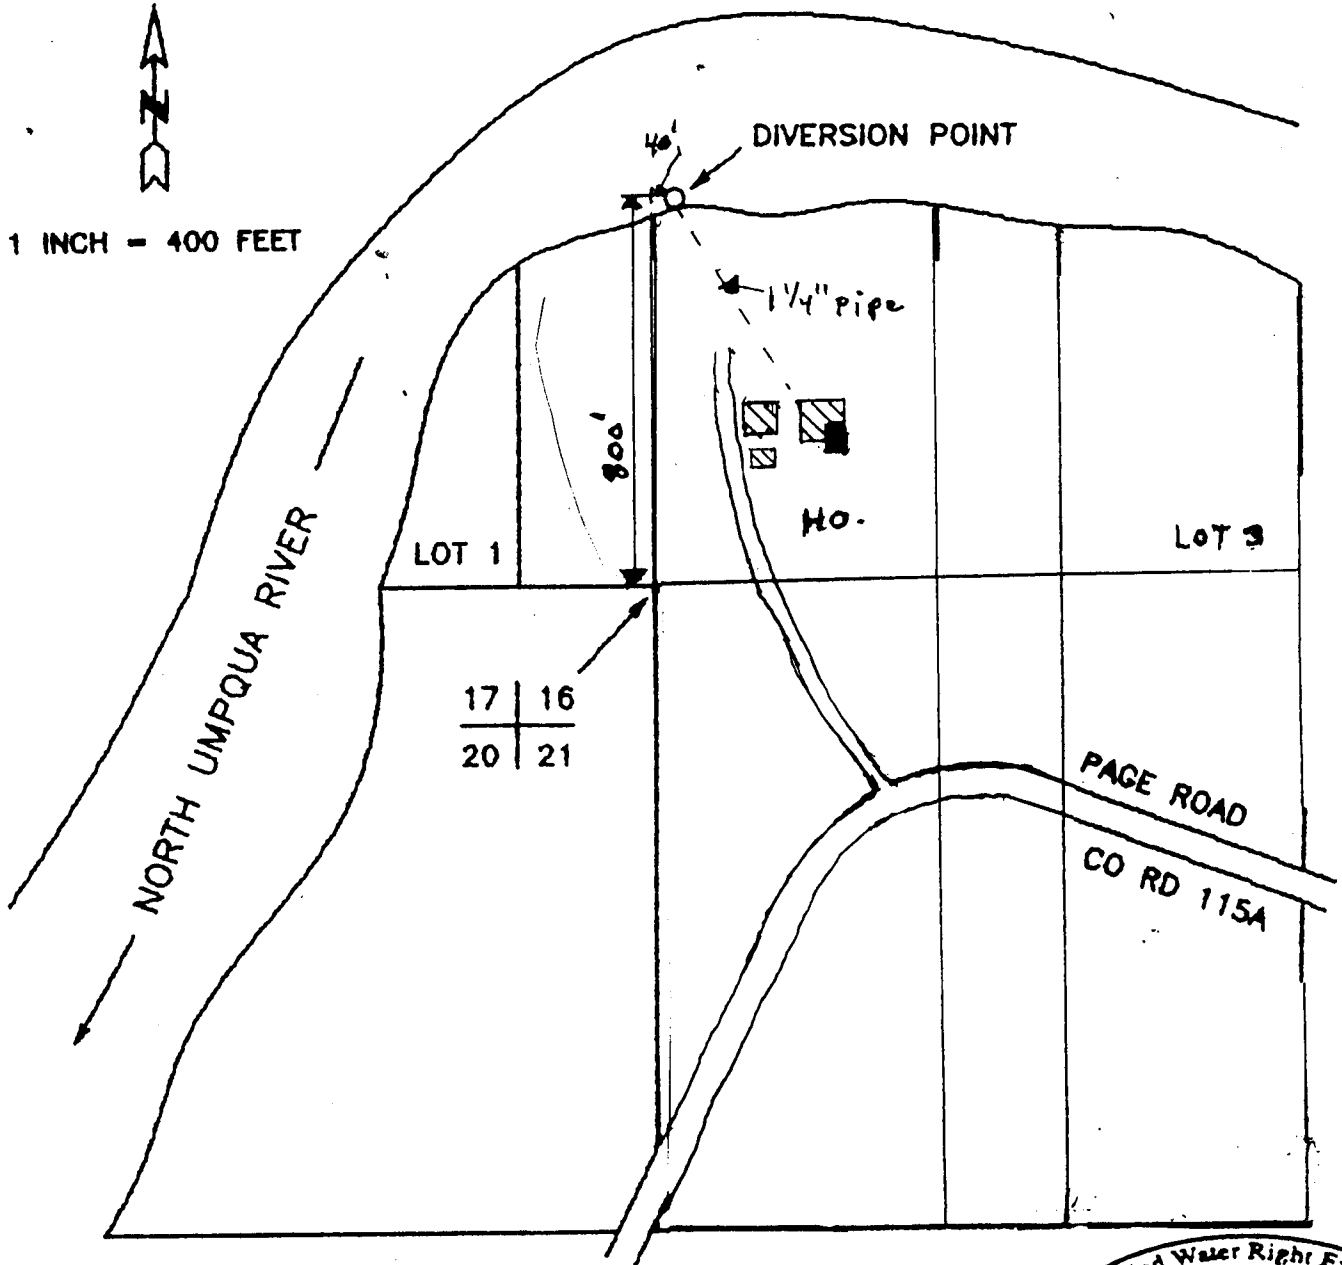

THE PURPOSE OF THIS MAP IS TO IDENTIFY THE LOCATION OF THE WATER RIGHT. IT IS NOT INTENDED TO PROVIDE LEGAL DIMENSIONS OR THE LOCATION OF PROPERTY OWNERSHIP LINES.

Certified Water Right Examiner
#214 WRE
Duane W. Kirby
Duane W. Kirby
May 30, 1989
STATE OF OREGON