



RECEIVED
 SEP 26 2000
 WATER RESOURCES DEPT.
 SALEM, OREGON

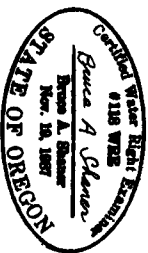

Scale: 1" = 400 ft.

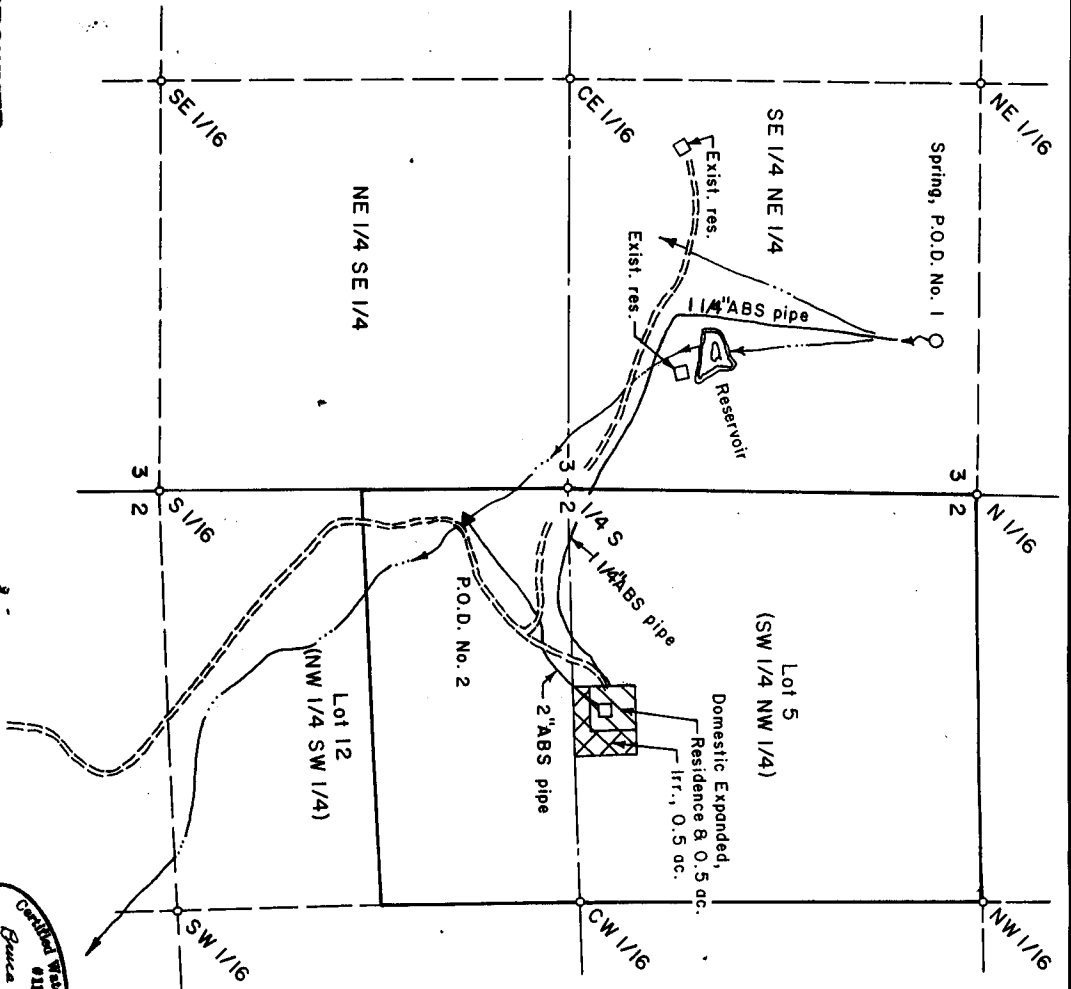

POINTS OF DIVERSION

1. 1,180 ft. North & 480 ft. West of the east 1/4 corner of Section 3.
2. 330 ft. South & 90 ft. East of the west 1/4 corner of Section 2.

**FINAL PROOF SURVEY OF A
 PERMIT TO APPROPRIATE SURFACE WATER
 FROM LOTS 5 & 12 OF SECTION 2 & THE
 SE 1/4 NE 1/4 OF SECTION 3, T 26 S, R 3 W,
 W. M., DOUGLAS COUNTY, OREGON**

Application No. 72896
 Permit No. 52272

For: Carol Cheatham
 P.O. Box 307
 Idleyd Park, Oregon 97447

By: Shaner Engineering, Inc.
 P.O. Box 1430
 Roseburg, Oregon 97470

September 25, 2000