


RECEIVED

JUL 07 1999
WATER RESOURCES DEPT
SALEM, OREGON

T. 17 S. R. 6 W. W. M.
SECTION 17
LAKE COUNTY, OREGON

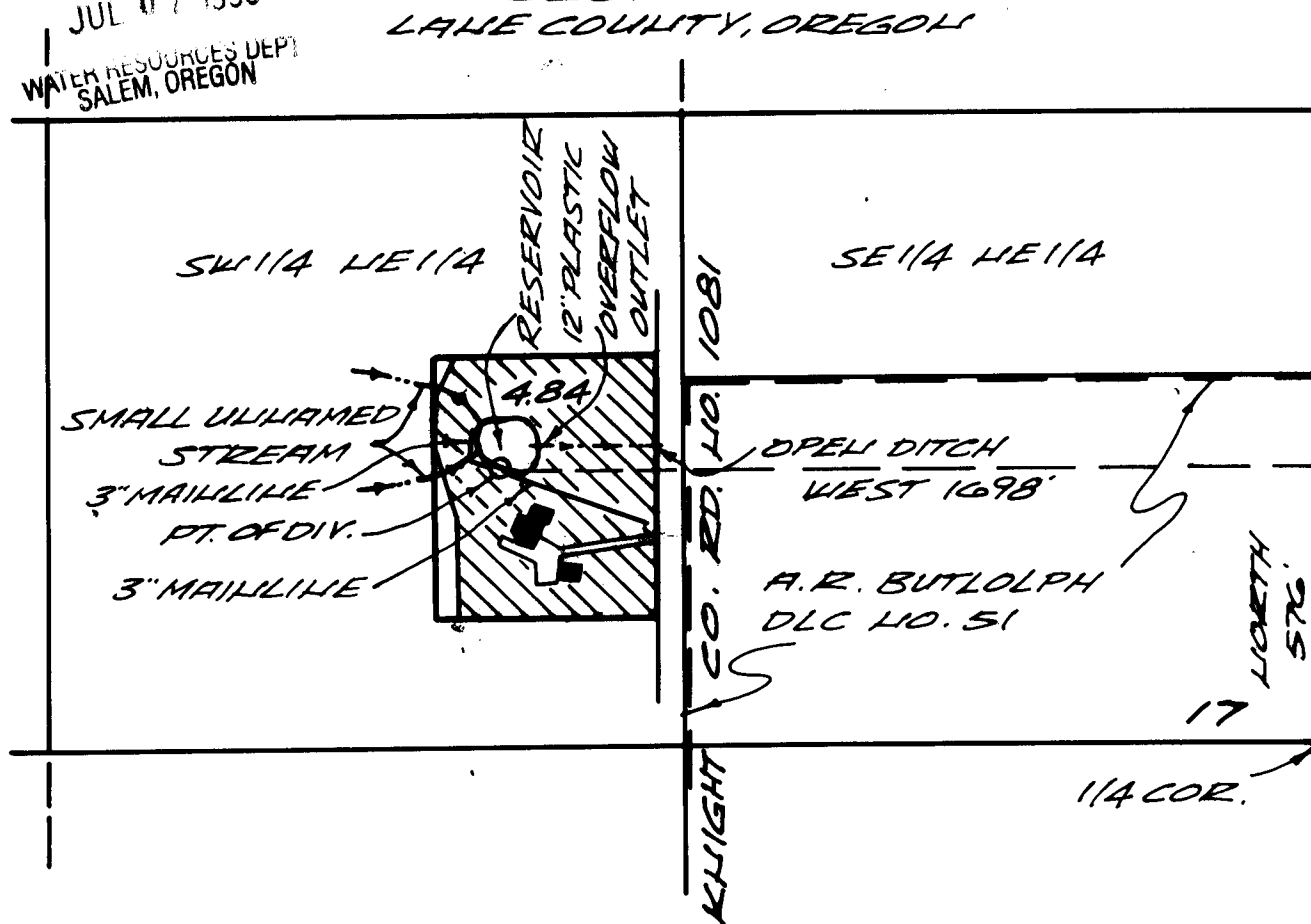

SCALE
1" = 400'

FINAL PROOF SURVEY UNDER

APPLICATION NO. S-81908 PERMIT NO. 53323

IN NAME OF

R. CLIFFORD KELLEY


SURVEYED JUNE 8, 1999 BY CHARLES W. GUILLE

POINT OF DIVERSION IS
576 FEET NORTH AND
1698 FEET WEST FROM THE
EAST 1/4 COR. SEC. 17,
T. 17 S. R. 6 W. W. M.

PRIORITY DATE
JANUARY 21, 1997

THIS MAP IS FOR WATER RIGHT
PURPOSE ONLY AND IS NOT
INTENDED TO PROVIDE
DIMENSIONS FOR LOCATING
PROPERTY BOUNDARIES.

CHARLES W. GUILLE
& ASSOCIATES, CO.
Land Surveying
82 Centennial Loop
Eugene, OR 97401

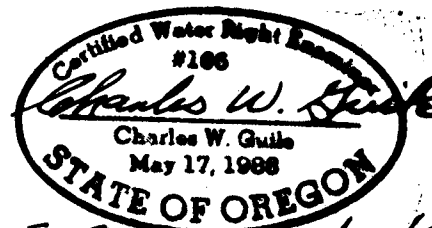

EXA DATE 6/30/1999
JUNE 22, 1999

99-19