

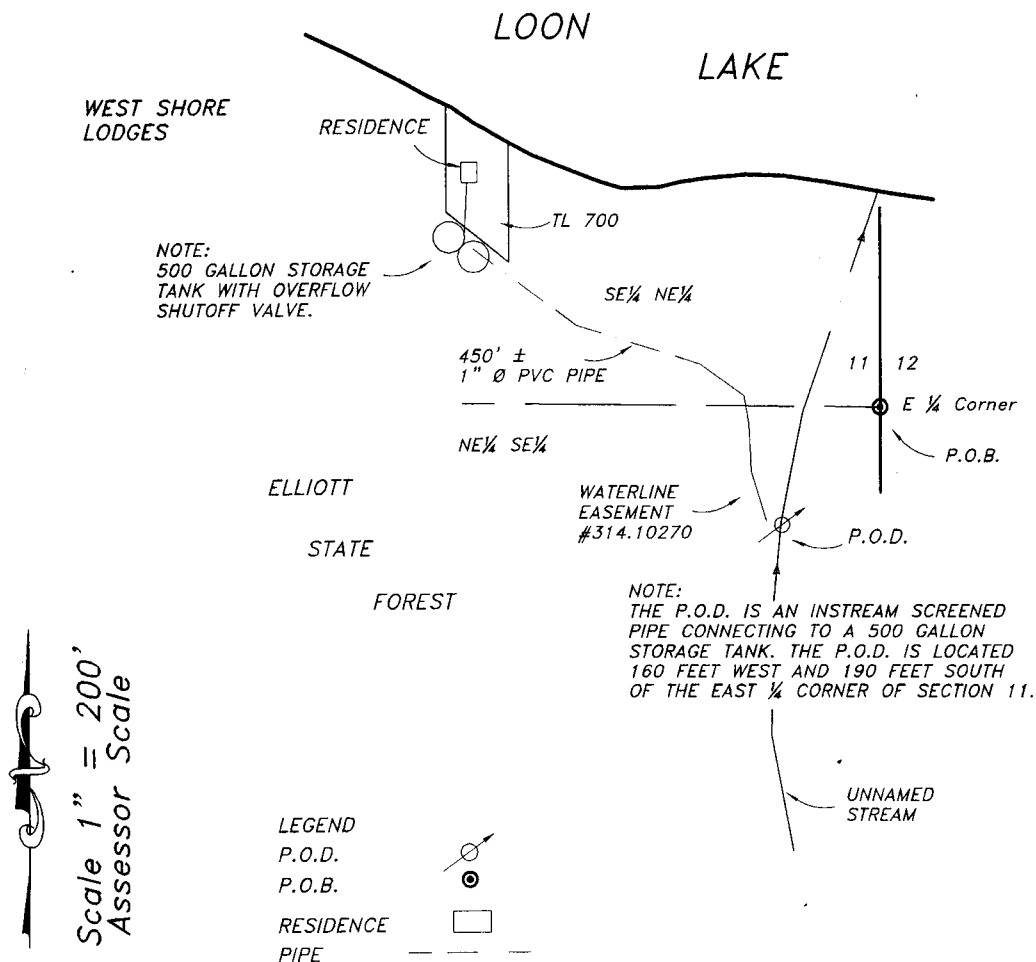
CLAIM OF BENEFICIAL USE

FINAL PROOF MAP

Located in the SE $\frac{1}{4}$ NE $\frac{1}{4}$ & NE $\frac{1}{4}$ SE $\frac{1}{4}$
of Section 11, Township 23 South, Range 10 West, W.M.
Douglas County, Oregon
Application #83409 Permit #53487

RECEIVED

MAR 28 2000

WATER RESOURCES DEPT.
SALEM, OREGON

Prepared For: John M. Ranes & Candi Williams
Prepared By: Dennis Goude
Surveyed: February 11, 2000



EXPIRES 06/30/2001

Stuntzner Engineering & Forestry, L.L.C.

ENGINEERING • LAND SURVEYING • FORESTRY
PLANNING • WATER RIGHTS

705 South 4th St. Phone: (541) 287-2872
Post Office Box 118 Fax: (541) 287-0588
Coos Bay, Oregon 97420

Drawn By: Dennis Goude	Date: February 10, 2000
Checked By: Tom Hoshall	Drawing No.: 99-233
Designed By:	Revised:
Job Name: Ranes Final Proof	Sheet 1 of 1

EXAMINERS DISCLAIMER STATEMENT

The preparation of this map was for the purpose of identifying the location of the Water Right only and has no intent to provide dimensions or location of property ownership lines.