


T. 23 S., R. 9 W., W. M.

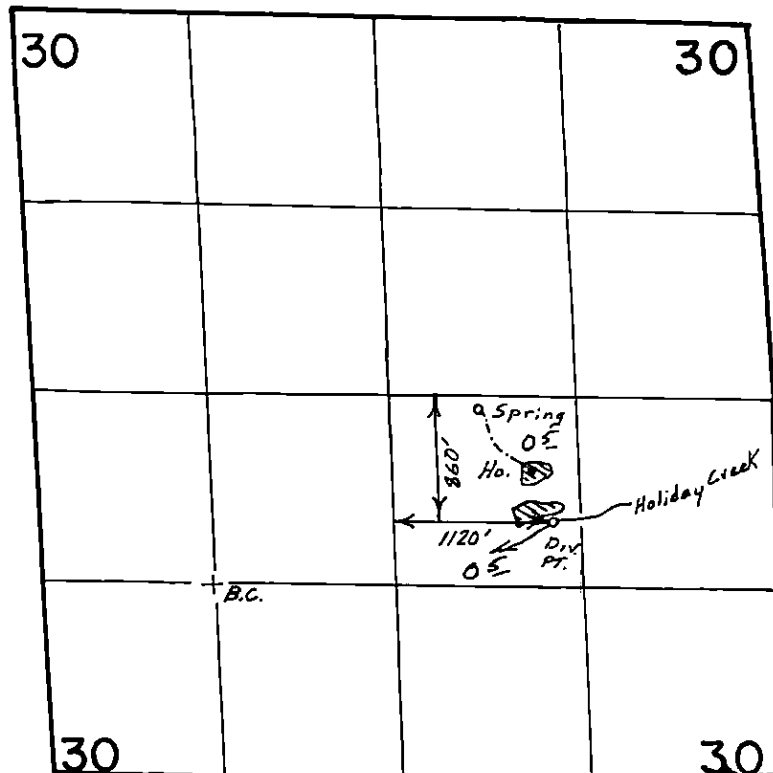

Spring-110' S & 600' E from C 1/4 corner.

Scale 1" = 1320'

FINAL PROOF SURVEY
UNDER

Application No. 55762 Permit No. 42226...
IN NAME OF

...WENDY...ARTIACO...LYNN.....

Surveyed Sept. 15.. 1994., by S. DeHaas.....