


T.7S.,R.2W.,W.M.

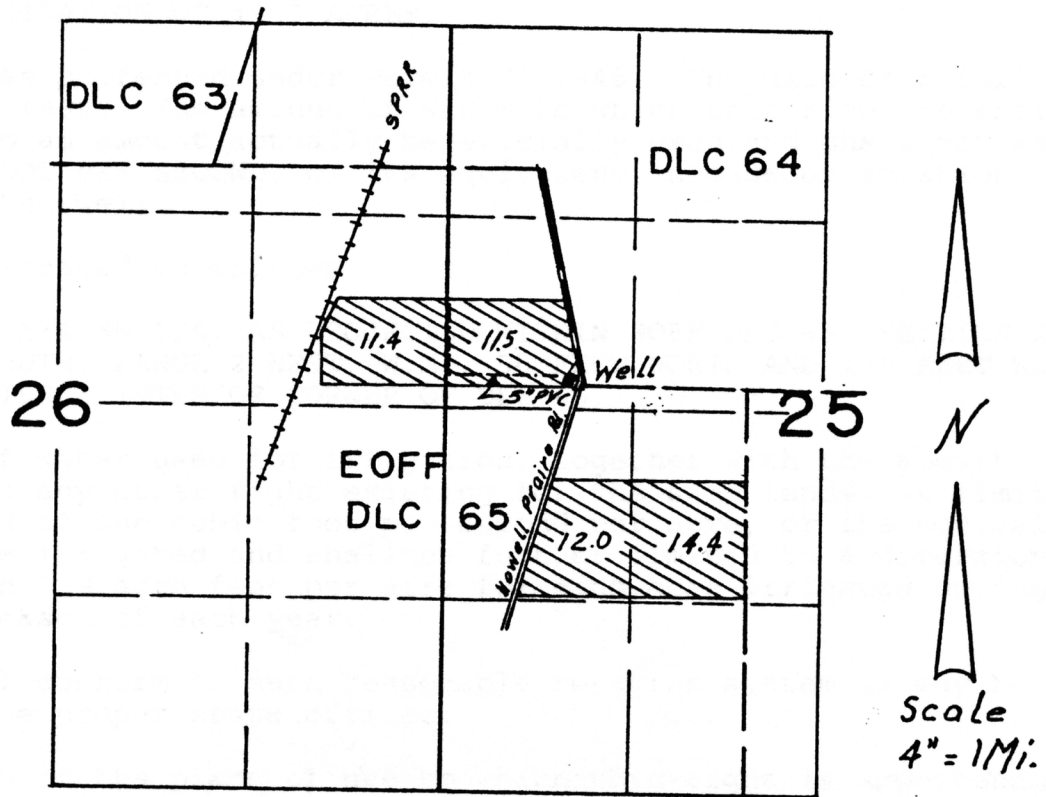

Well loc. 50' N & 100' W from Int. E11 cor Eoff DLC 65

FINAL PROOF SURVEY

UNDER

Appl. No. G-12337 Permit No. G-11345

RANDALL STEFFEN

THIS MAP WAS PREPARED FOR THE PURPOSE OF IDENTIFYING THE LOCATION OF A WATER RIGHT ONLY AND IS NOT INTENDED TO PROVIDE LEGAL DIMENSIONS OR LOCATION OF PROPERTY OWNERSHIP LINES.

