


Township 13 S., Range 31 E., W.M.

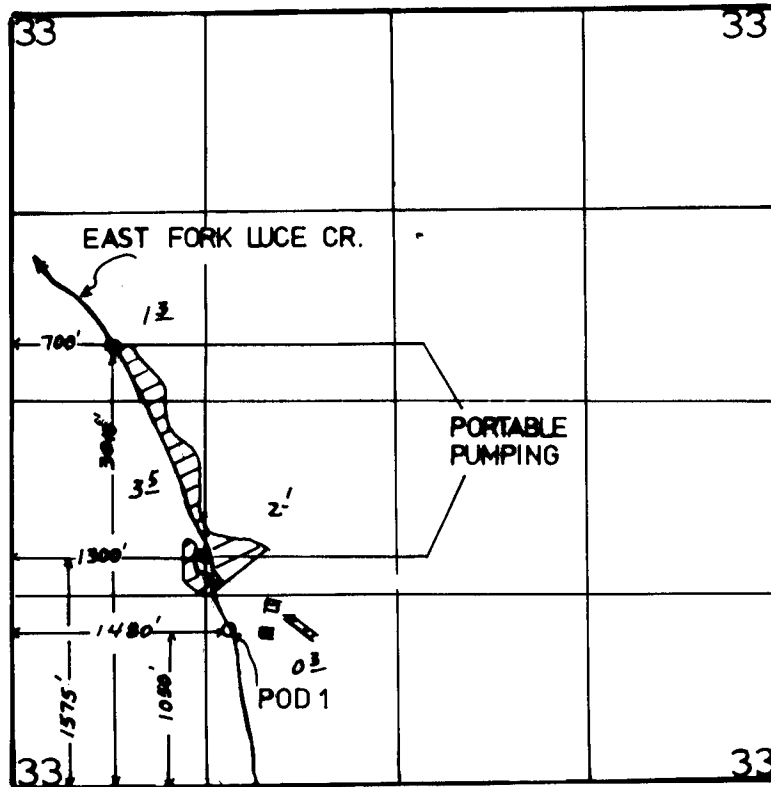

-  PORTABLE PUMPING
-  POD 1

1"= 1320'

FINAL PROOF SURVEY UNDER

Application No. 55187 Permit No. 41353
IN NAME OF

Surveyed August 12 99 by J. Miller
19....., by