


T. 23S., R. 10W., W.M.

Section 25

SW 1/4 NE 1/4

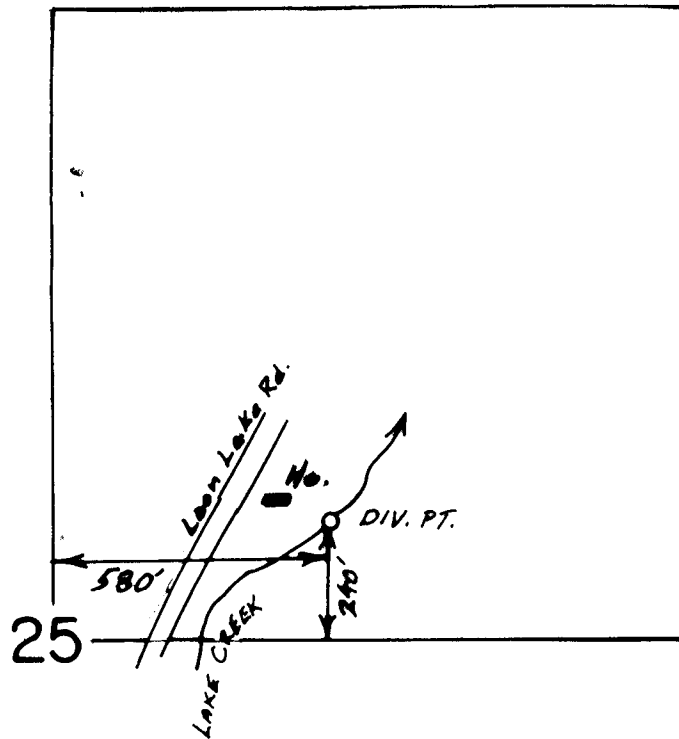

Scale 1" = 400'

**FINAL PROOF SURVEY
UNDER**

Application No. 57374 Permit No. 43165....
IN NAME OF

ELVIN L. STINGLEY

Surveyed Sept. 15, 1994, by S. DeHaas.....