


T. 23 S., R. 9 W., W.M.

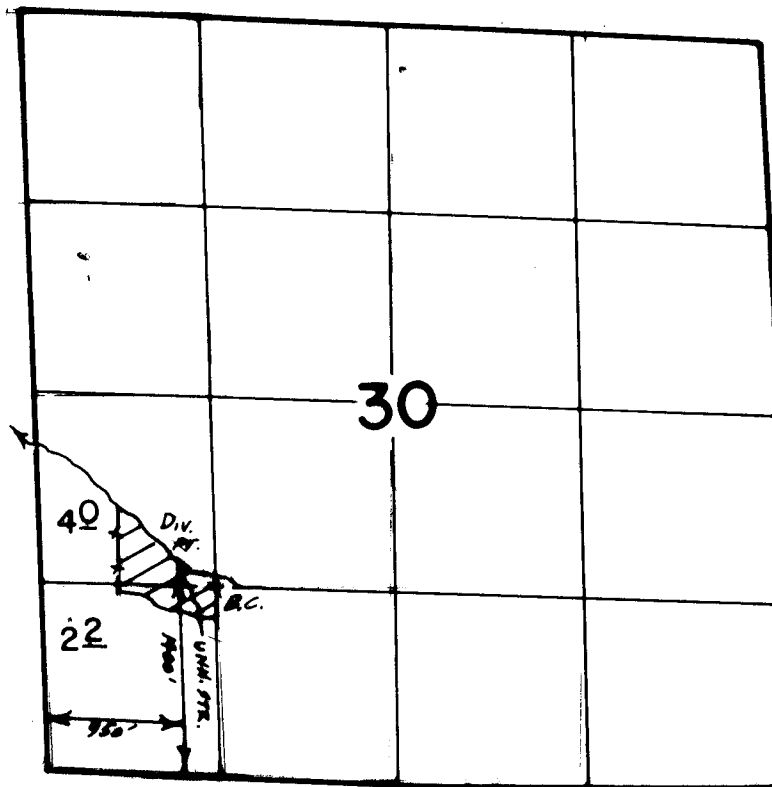

Scale 1" = 1320'

FINAL PROOF SURVEY
UNDER

Application No. 58523 Permit No. 44129.....
IN NAME OF

.....JAMES...A...EDD.....

Surveyed Sept. 15.. 1994., by S. DeHaas.....