


T. 32 S., R. 14 W., W.M.

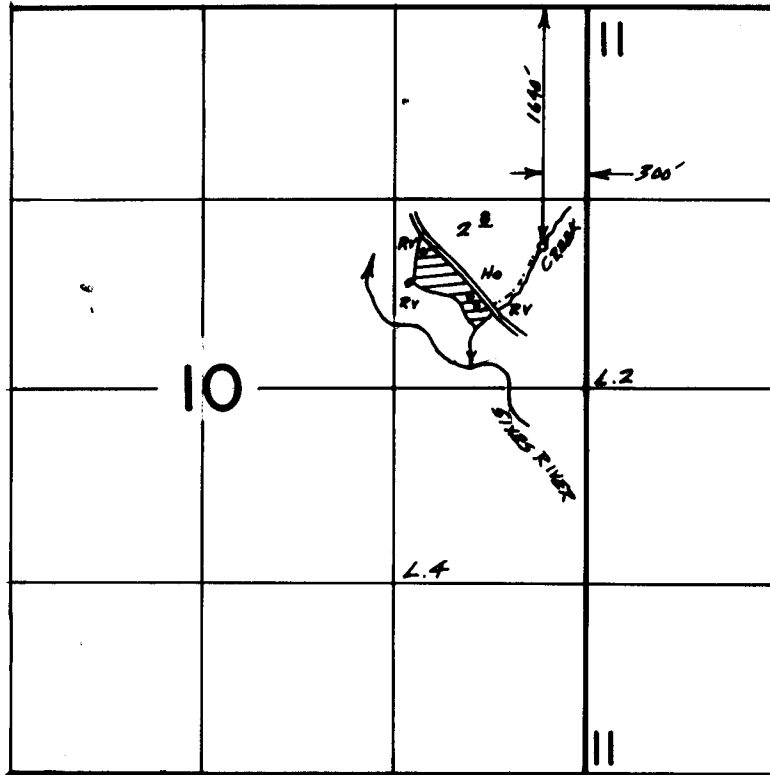

Scale 1" = 1320'

FINAL PROOF SURVEY
UNDER

Application No. 60383 Permit No. 46579...
IN NAME OF

.....MICHAEL.....DUSSAULT.....

Surveyed Sept. 25, 1991., by B.S. JAMES....