


AUG 13 1997
WATER RESOURCES DEPT
SALEM OREGON

THORNTON LAKE

PUMP:
LOCATED NORTH 170' & EAST 375'
FROM AN ANGLE POINT IN THE
NORTH LINE OF P.L.C. NO. 59.

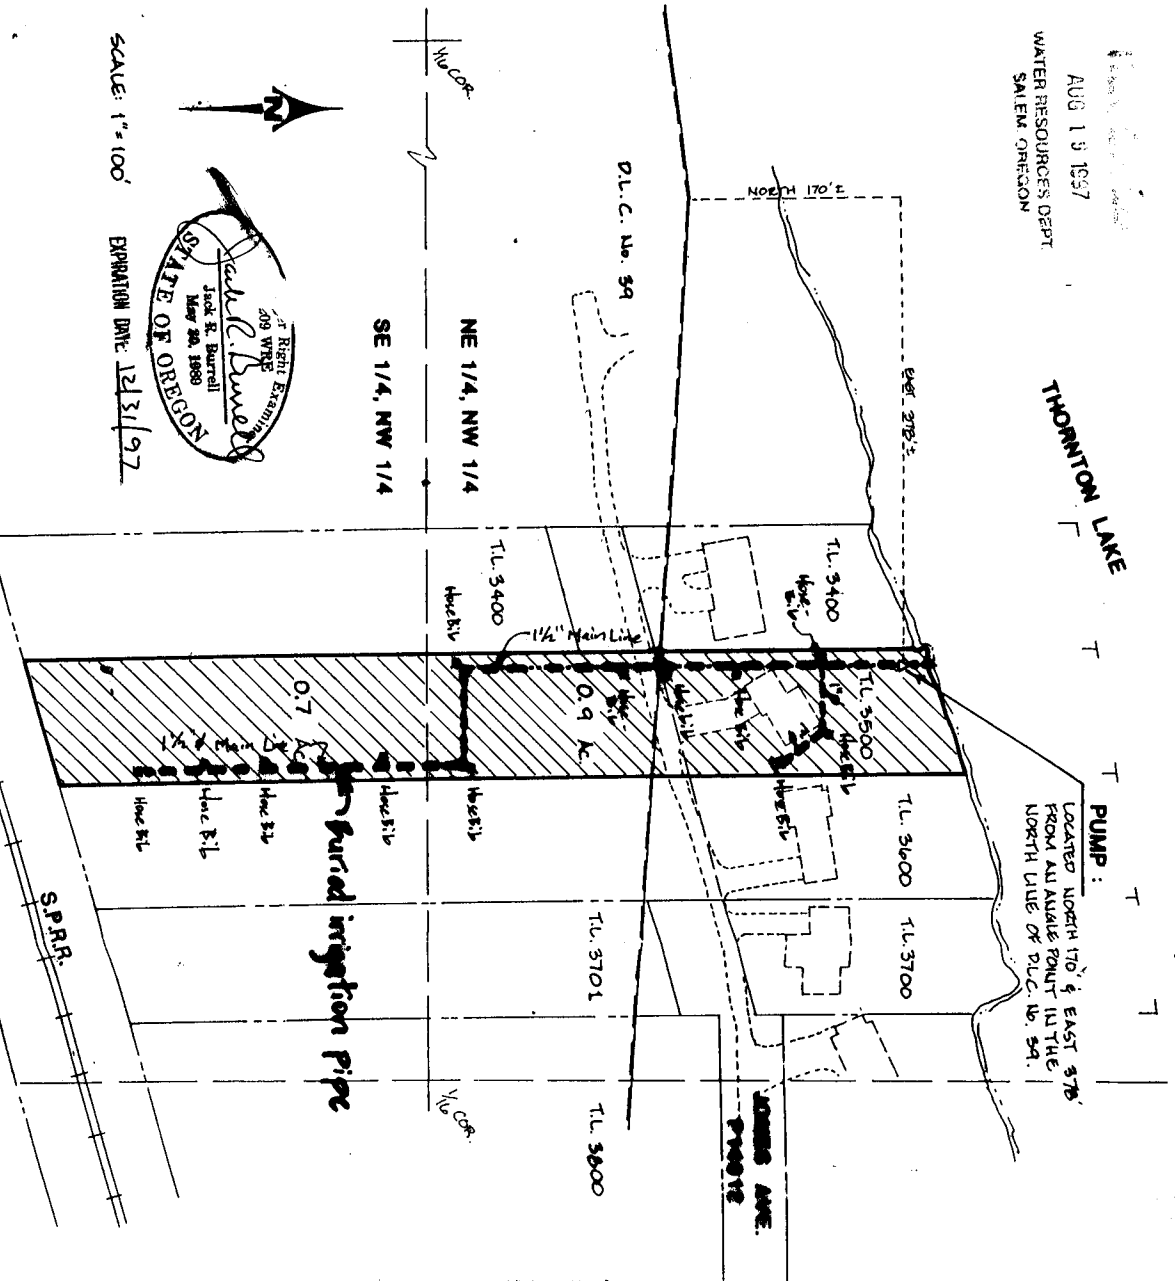

209 West Examiner
 209 West
 Jack R. Burrell
 May 20, 1980
 STATE OF OREGON
 SCALE: 1" = 100'
 EXPIRATION DATE: 12/31/97

KD
ENGINEERING, INC.
 808 NW HICKORY STREET
 POST OFFICE BOX 7285
 ALBANY, OREGON 97381

WHITE WATER RIGHT
 LOCATED IN
 SEC. 1, T.11S. R.4 W. WM, BENTON COUNTY, OR.

FINAL PROOF SURVEY

Under

APPLICATION S-73233

in the name of

JACK C. WHITE
 1111 Jones Avenue NW
 Albany, OR 97321

Surveyed By:
K & D ENGINEERING, INC.
 August 18, 1997

Tax Lot: 3500 (11.4W-1BA)
 Source: Thornton Lake

Proposed Acres in Section 1
 Under S-73233 is 1.6 acres broken down by quarter-quarter
 Section as follows:

NE 1/4 NW 1/4	=	0.9 Acres
SE 1/4 NW 1/4	=	0.7 Acres
TOTAL	=	1.6 ACRES

I, JACK R. BURRELL, BEING DULY SWORN AS A WATER RIGHT EXAMINER LICENSE NO. 209 HAVE PREPARED THIS MAP FOR JACK C. WHITE ON THIS 18TH DAY OF AUGUST 1997. THE AREAS HATCHED REPRESENT THE ACREAGES BEING IRRIGATED AT THE TIME OF THE SURVEY.

PREPARATION OF THIS MAP IS FOR THE PURPOSE OF IDENTIFYING THE LOCATION OF THE WATER RIGHT ONLY AND HAS NO INTENT TO PROVIDE DIMENSIONS OR LOCATION OF PROPERTY OWNERSHIP LINES.

585N. BY: N/A
 DWG. BY: M.M.S.
 CRO. BY: J.R.B.

SCALE: 1" = 100'
 DATE: JAN 7, 1995
 PROJECT NO: 92-144

SHEET NO. 1