


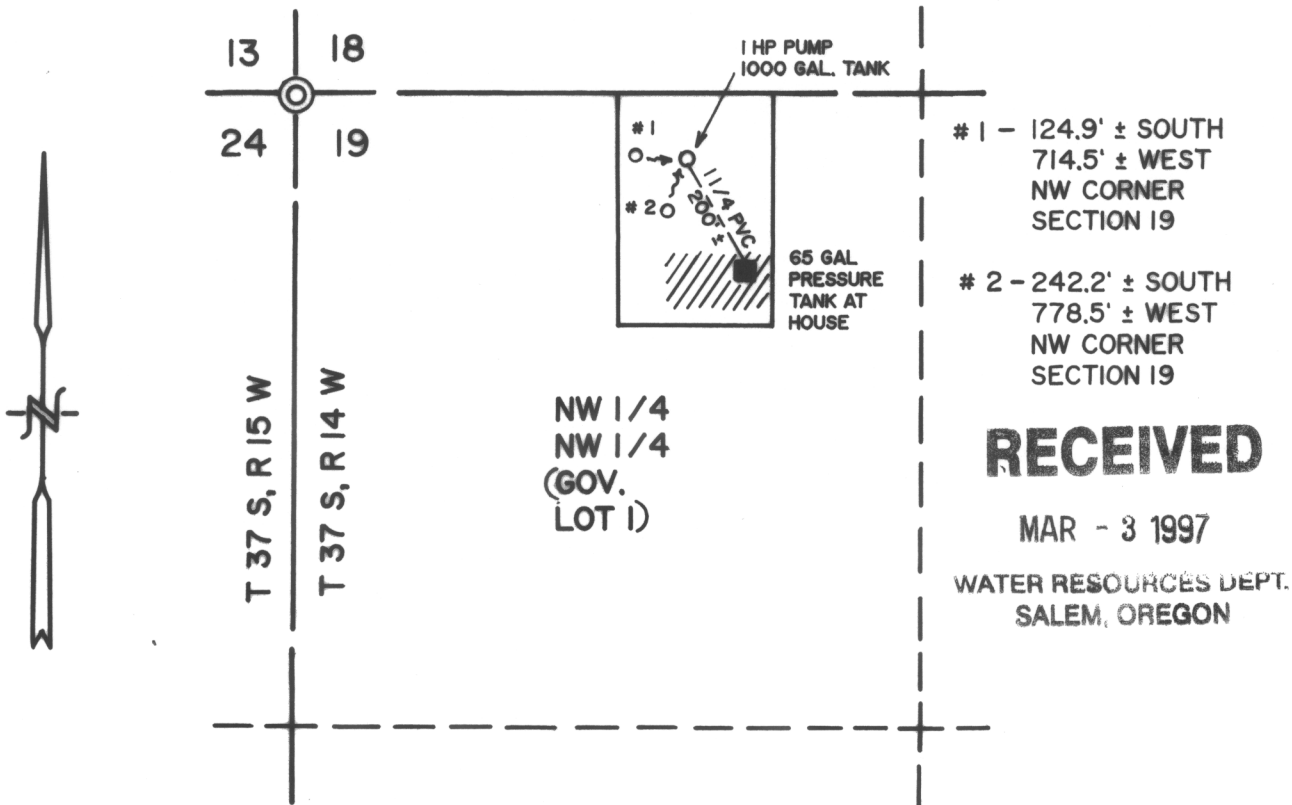

THE PREPARATION OF THIS MAP WAS FOR THE PURPOSE OF IDENTIFYING THE LOCATION OF THE PROPOSED WATER RIGHT AND HAS NO INTENT TO PROVIDE DEMENSIONS OR LOCATION OF PROPERTY LINES.

# T 37 S, R 14 W, W.M. SECTION 19 FINAL PROOF SURVEY

UNDER  
APPLICATION #S-74159 PERMIT #52542  
IN THE NAME OF

## JAMES WORLEDGE

SURVEYED JANUARY 20, 1997 BY H.J. NEWHOUSE

SCALE 1" = 400'

