RECEIVED
APR 08 2002
WATER RESOURCES DEPT.
SALEM, OREGON

RECEIVED
FEB 21 1957
STATE ENGINEER
SALEM, OREGON

RECEIVED
NOV 14 1957
STATE ENGINEER
SALEM, OREGON

REGISTERED
OREGON
LAND SURVEYOR
ARNE L. GRAVI
2

SURVEY # 24L
for
H.E. Willman. - Sec 11 T8NR7W
Sub-Division of Davis Estate
WATER SYSTEM PIPELINE
Scale 1" = 200' 4/24/56

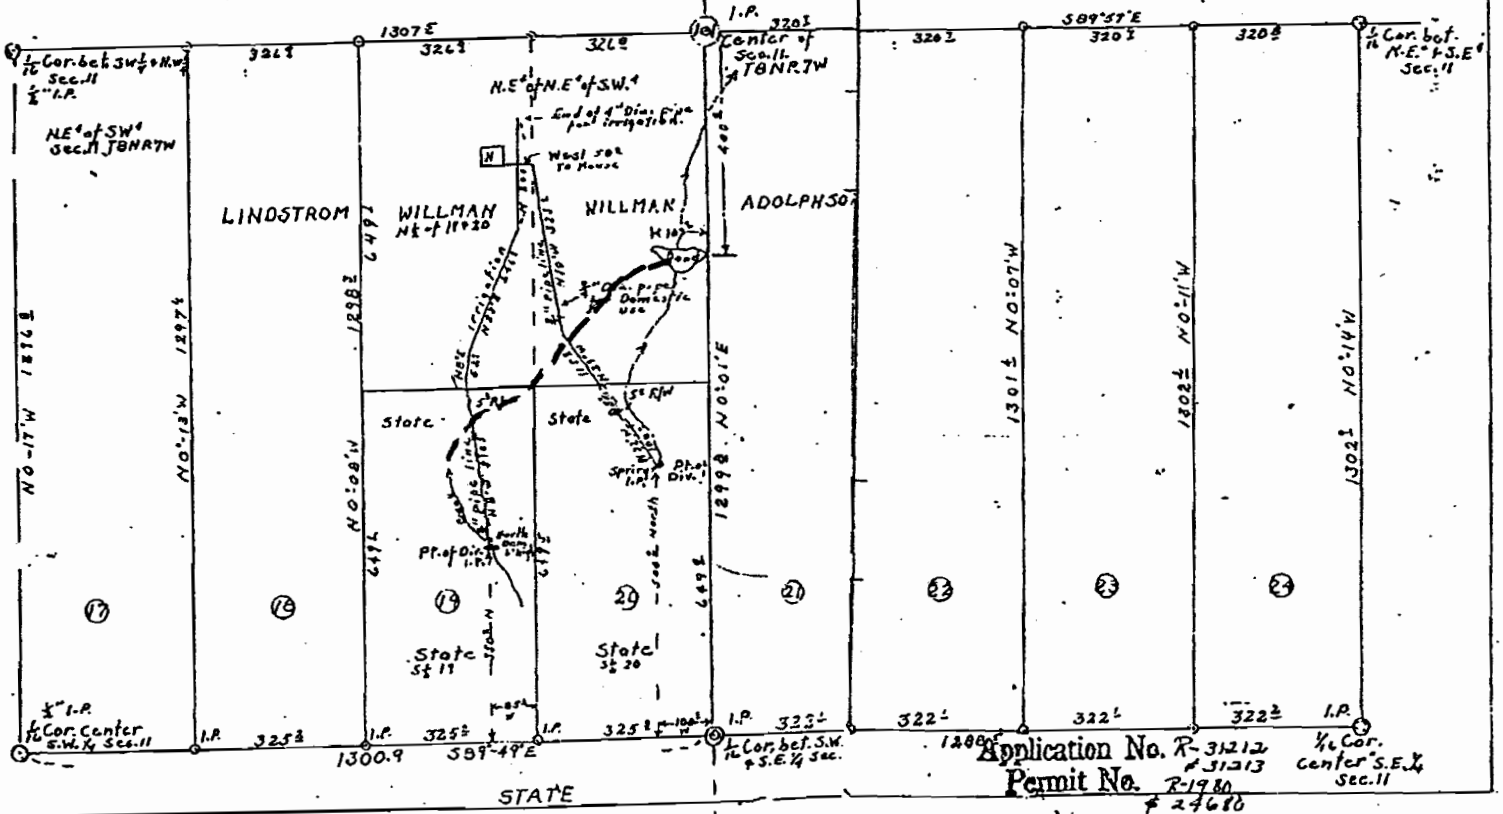

Application No. R-31212 & 31213
Permit No. R-1980 & 24680