Final Proof Survey Map
T 7 S R 4 W W.M.
Portions of sections 3 and 10

RECEIVED
[illegible] 3 [illegible]
WATER RESOURCES DEPT
SALEM, OR

prepared for Grant G. Brunker

Application # G-14089 Permit # G-13124

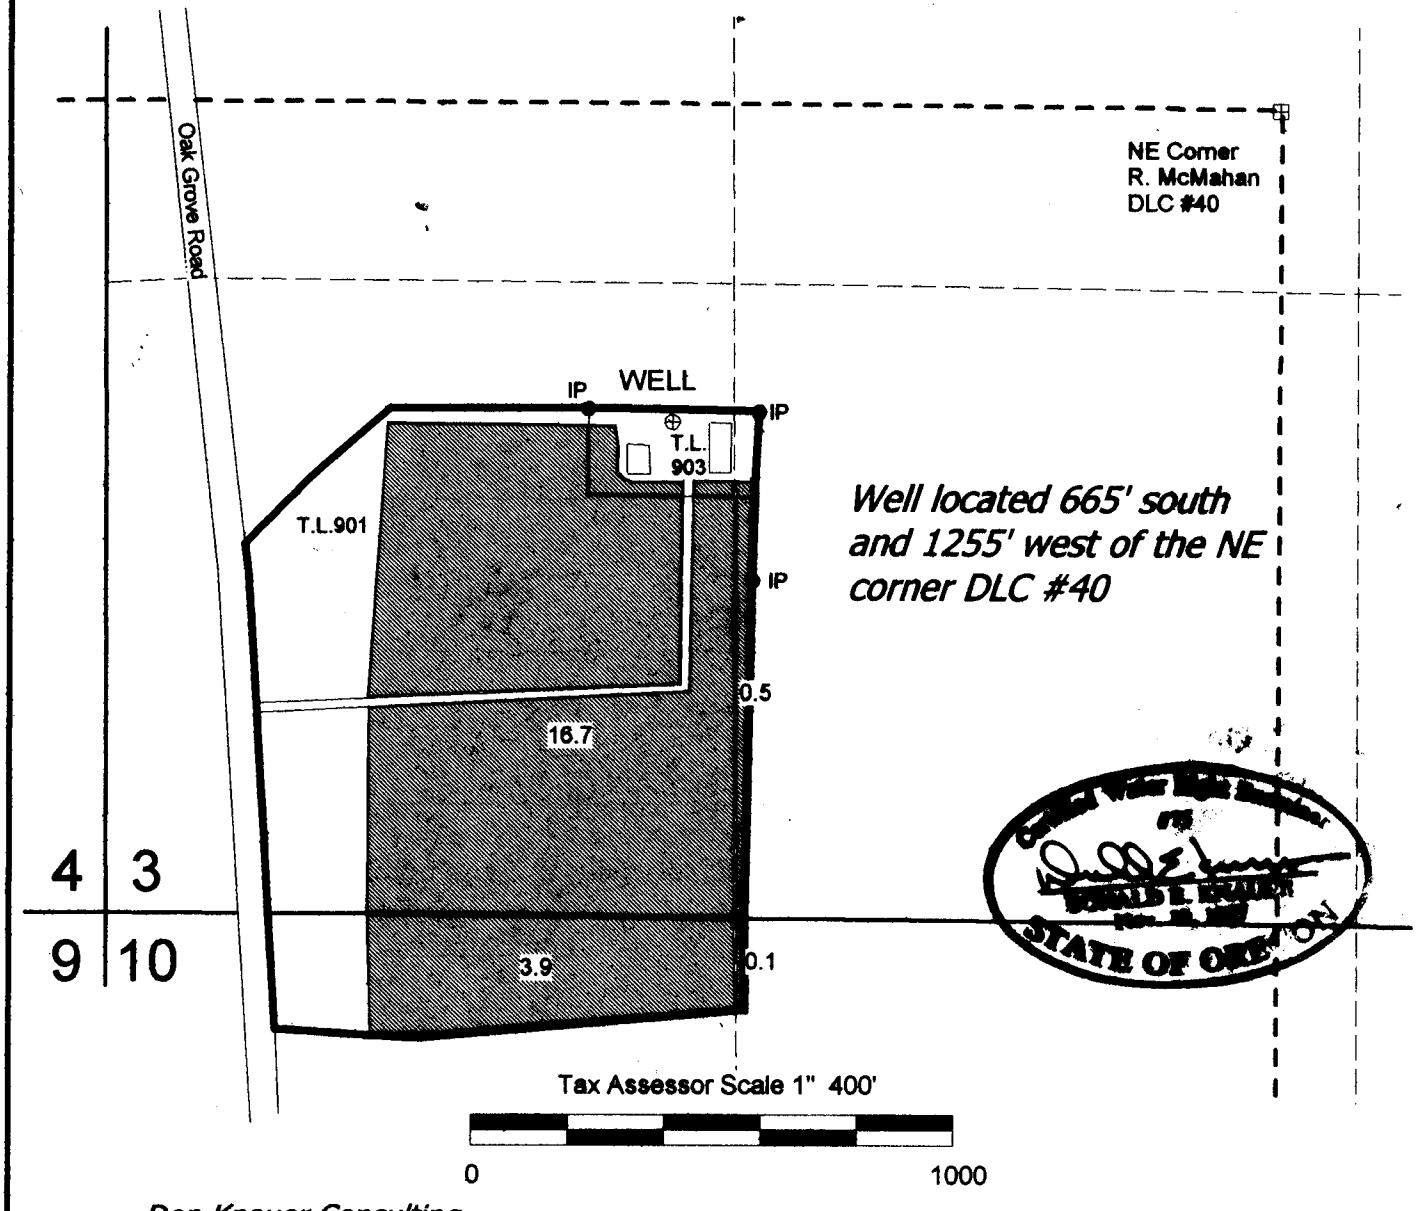

Well located 665' south and 1255' west of the NE corner DLC #40

Don Knauer Consulting
PO Box 5416
Salem OR 97304
503-585-8474

This map is to be used for water right purposes only.