


T.8S., R.3W., W.M

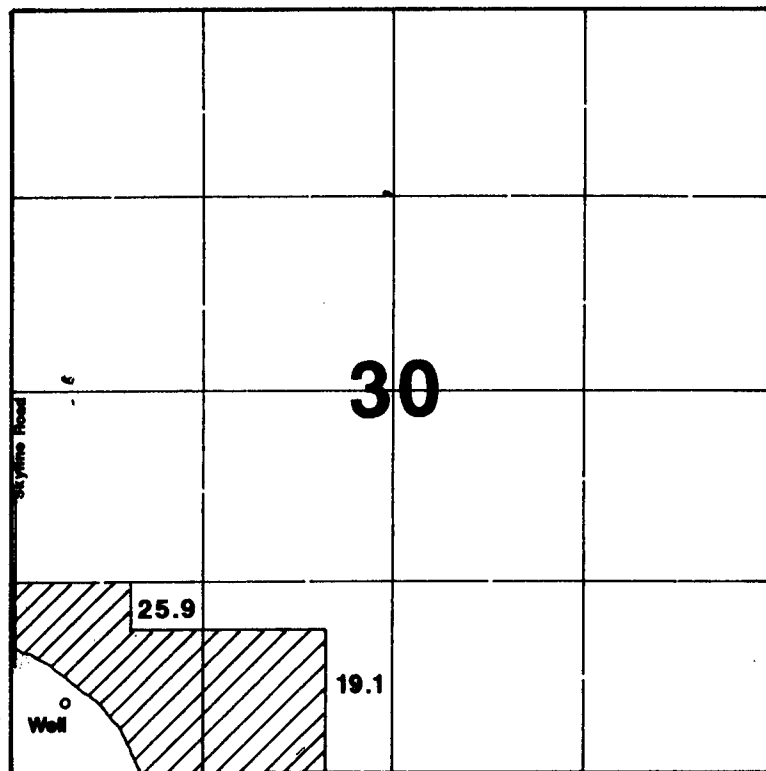

Well is located 500'N & 350'E from the SW corner of Section 30.

Final Proof Survey

In Name Of

Salem Hills Vineyard

Application #: G-14255 Permit #: G-12984

Surveyed on July 28, 2000 by JM Schuette

This Map Was Prepared For The Purpose Of Identifying The Location Of A Water Right Only And Is Not Intended To Provide Legal Dimensions Or Location Of Property Ownership Lines.

