


RECEIVED

OCT 12 1998


WATER RESOURCES DEPT.
SALEM, OREGON

SURVEY AND
MAP BASED ON
SURVEY M82-15
DOUGLAS COUNTY
SURVEYOR'S
OFFICE

SECTION 33, T31S, R1W, WM

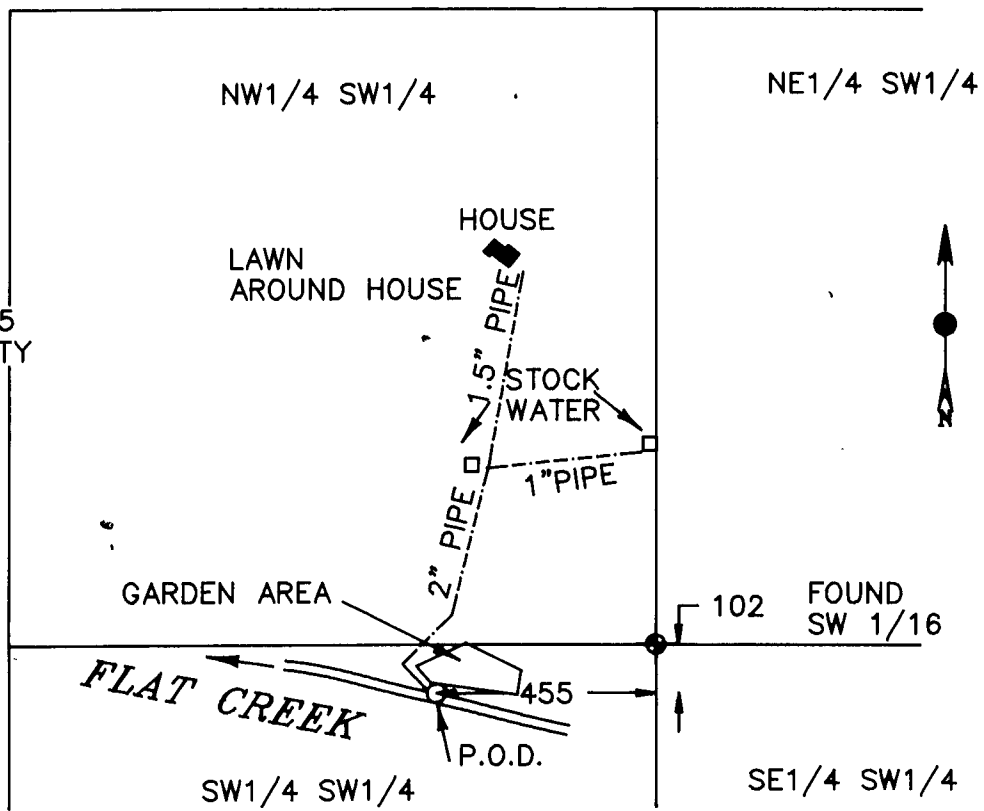

THIS MAP IS TO BE USED FOR WATER RIGHT PURPOSES ONLY

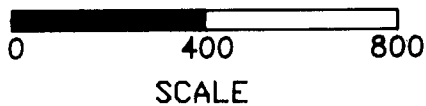


MAP TO ACCOMPANY CLAIM FOR BENEFICIAL USE OF SURFACE WATER
IN NAME OF

Richard and Wanda Gilliam

DATE August 8, 1998

BY: WILLIAM J. RUPPERT
P.O. BOX 1564
MYRTLE CREEK, OR 97457

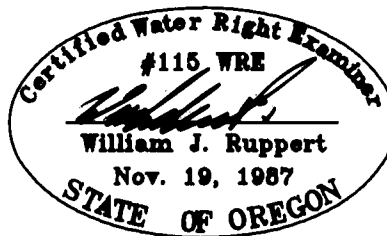

EXPIRES
12/31/98

Application 5-72454
Permit 5-52629