


MAP TO ACCOMPANY CLAIM OF BENEFICIAL USE FOR CHANGE
IN POINT OF DIVERSION AND PLACE OF USE

RECEIVED
C 07 2001

WATER RESOURCES DEPT.
SALEM, OREGON

for Randal and Lorraine Walls

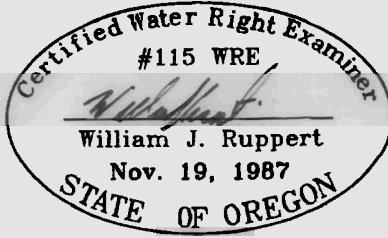


TRANSFER T-8493

MAP PREPARED BY:
WILLIAM J. RUPPERT
P.O. BOX 1564
MYRTLE CREEK, OR 97457
AUGUST & SEPTEMBER 2001

----- BURIED PIPE

SCALE 1"=1320'

T29S R3W WM

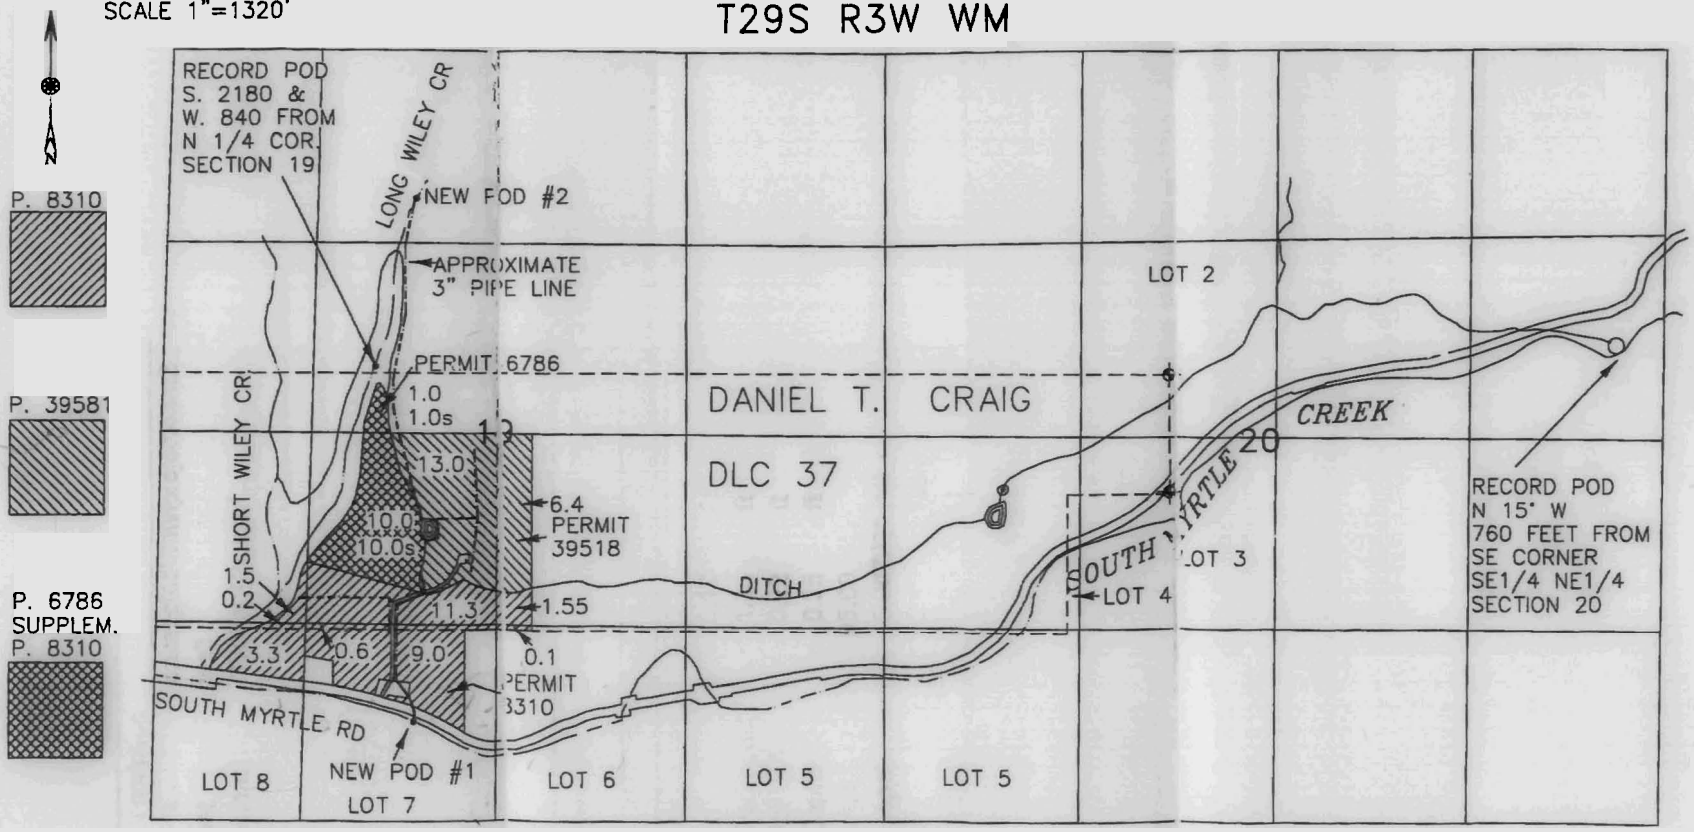

NEW POD #1 NORTH 680 FEET AND WEST 560 FEET FROM THE S1/4 CORNER SECTION 19, T29S R3W, WM
NEW POD #2 SOUTH 1020 FEET AND WEST 560 FEET FROM THE N1/4 CORNER SECTION 19, T29S R3W, WM
THIS MAP TO BE USED FOR WATER RIGHT PURPOSES ONLY