


FINAL PROOF SURVEY

SE 1/4, NE 1/4, SECTION 18,
LOT 4 AND LOT 5 SECTION 17
T. 14 S., R. 7 W., W.M.
BENTON COUNTY, OREGON
APPLICATION FILE NO. S-71533
IN THE NAME OF
NOVEMBER 11, 1997

MAY 26 1998
WATER RESOURCES DEPT.
SALEM, OREGON

THIS MAP IS FOR THE PURPOSE OF OBTAINING A
WATER RIGHT AND IS NOT INTENDED TO PROVIDE
LEGAL DIMENSIONS FOR LOCATIONS OF PROPERTY
BOUNDARIES.

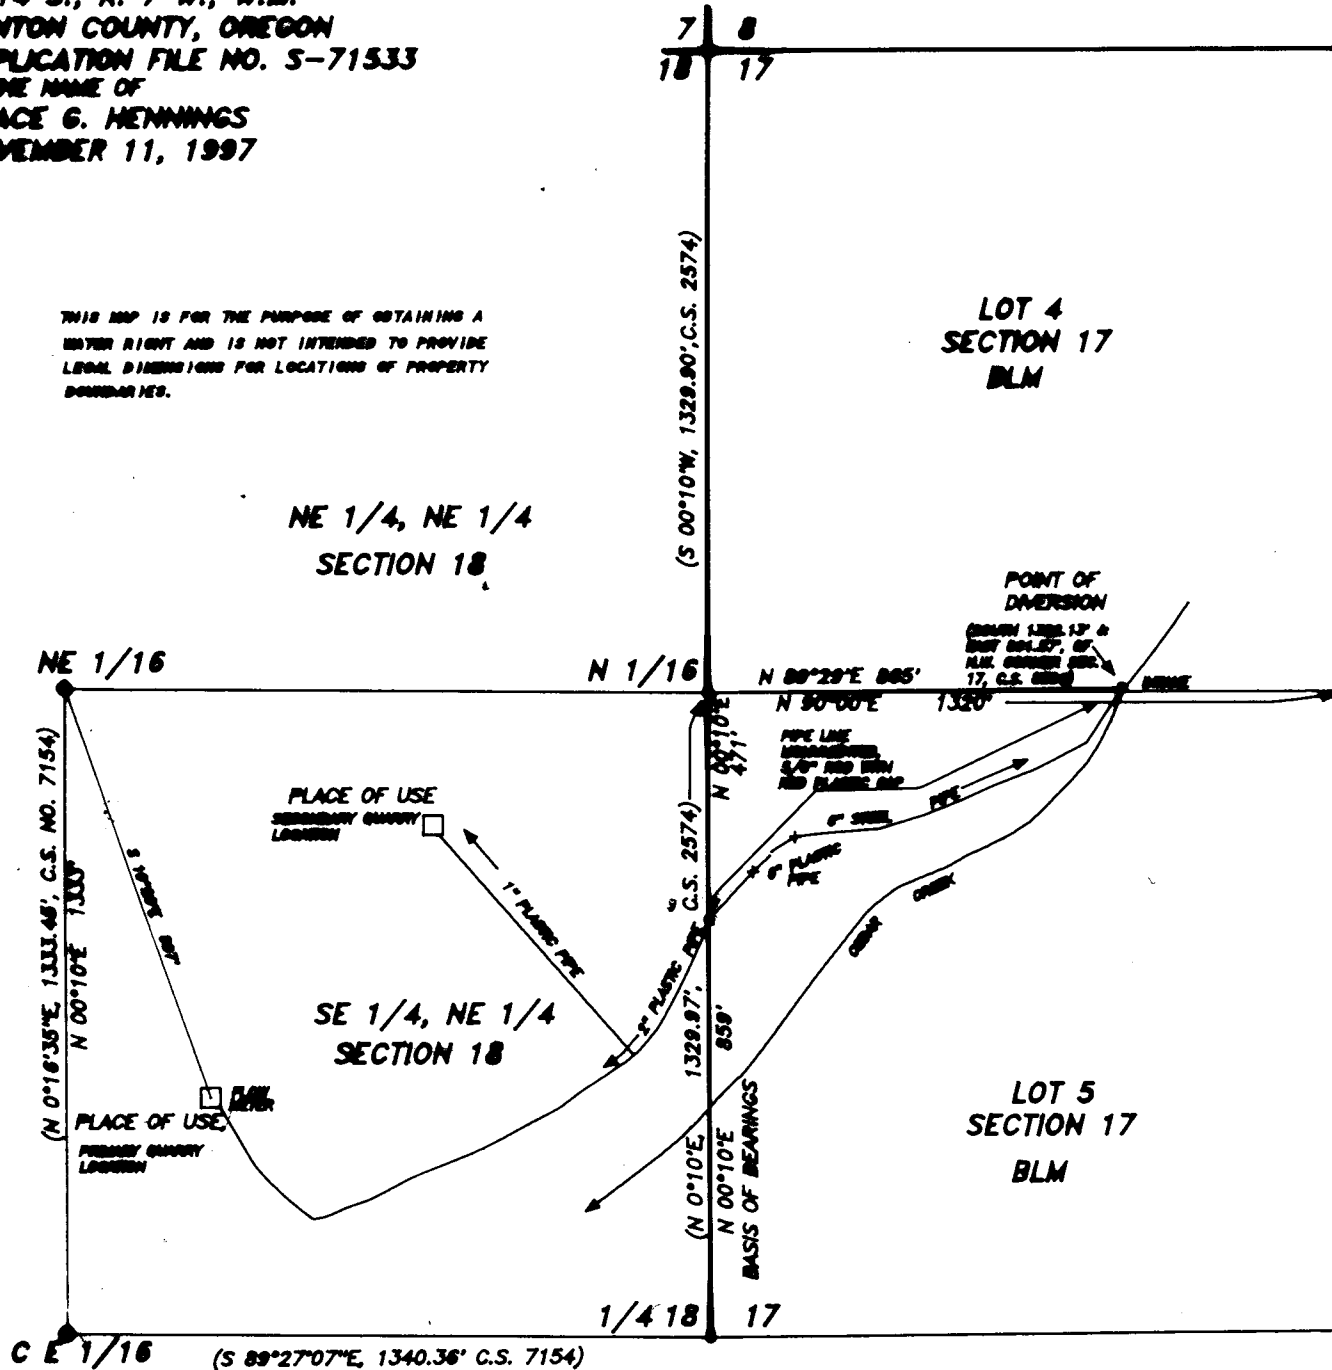

LEGEND

- () RECORD DATA
- 5/8" ROD TIED FROM C.S. NO. 7154
- COMPUTED POSITION

THE LOCATION OF THE WATER LINE IS FROM C.S. NO. 8896
AND THE APPLICATION MAP FOR THIS PROJECT DATED APRIL
10, 1991

SCALE 1 INCH = 400 FEET

SURVEYED BY:
L. W. HUNNEMULLER
3055 N. E. LANCASTER
CORVALLIS, OR 97330
PHONE: (541) 757-7614

