
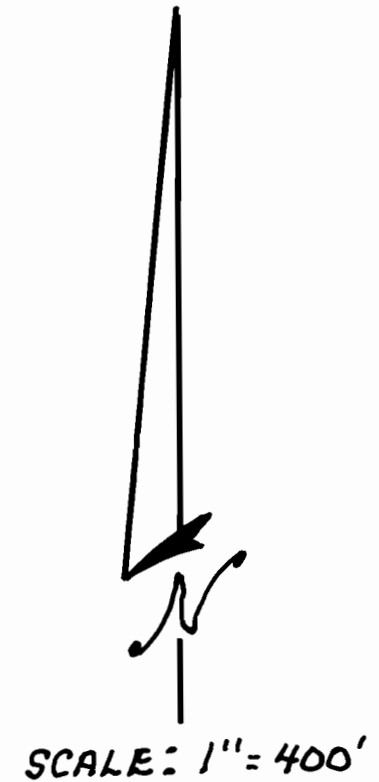


T38S R11E W.M.

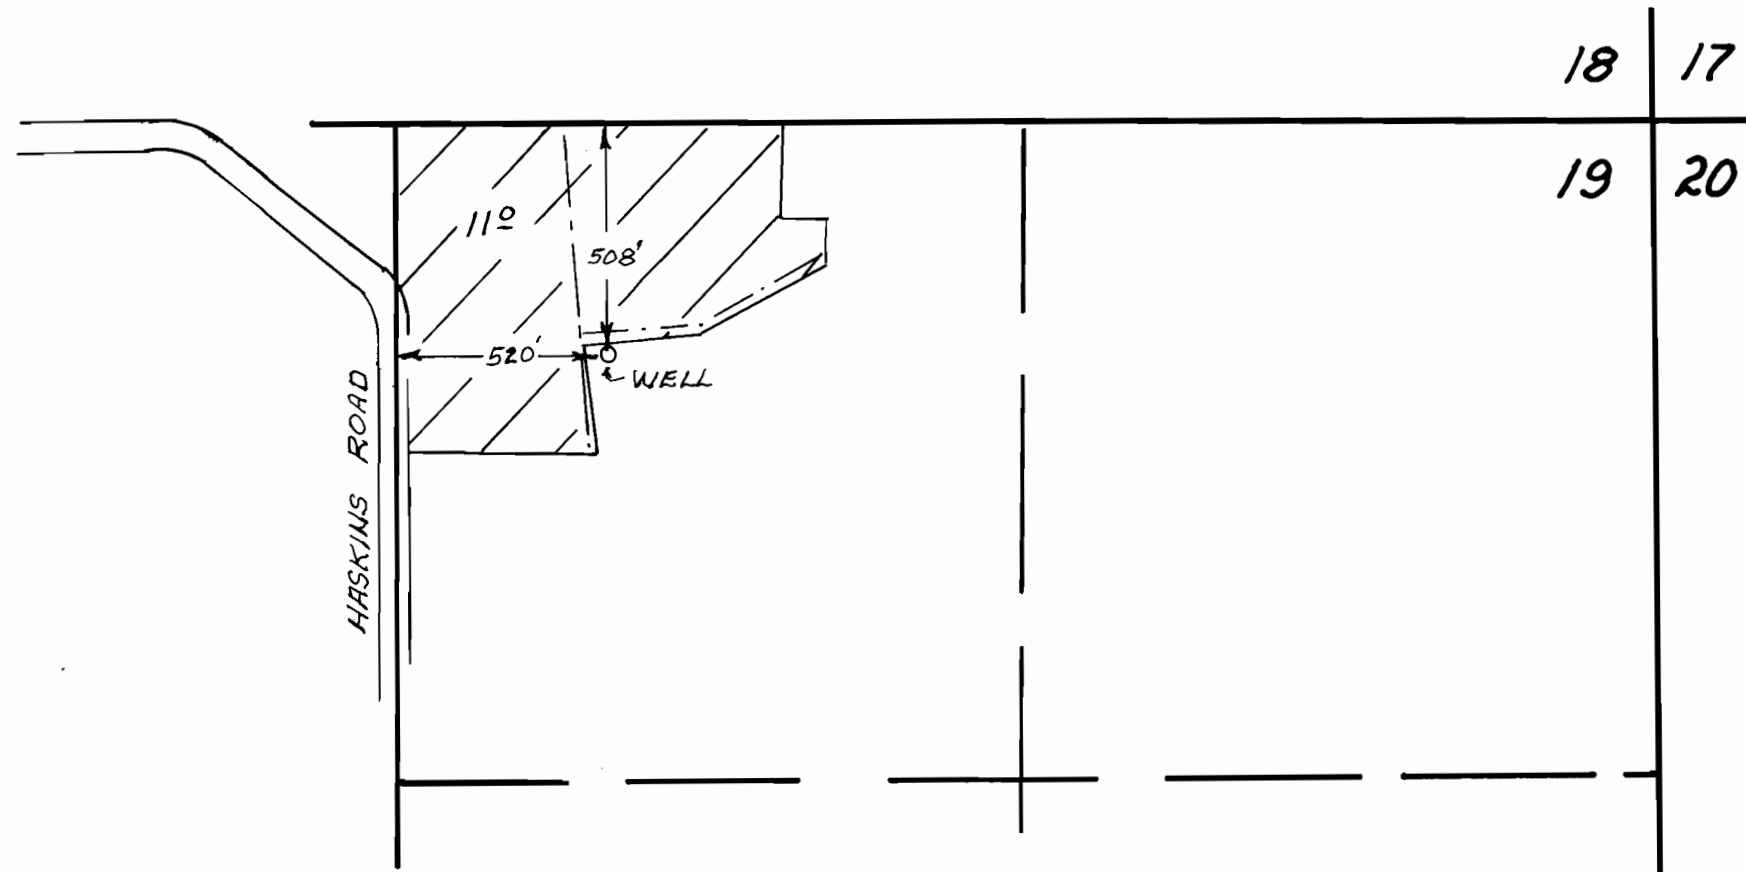

FINAL PROOF SURVEY


UNDER

APPLICATION No. G-13349 PERMIT No. G-12634

IN THE NAME OF

LANCE AND KEM WATSON

SURVEYED: JANUARY 18, 2000 BY: DONALD A. GRESDEL
WRE 240

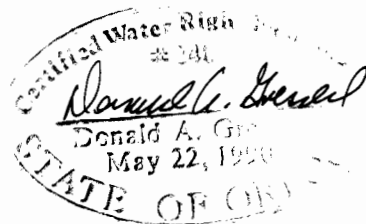

EXPIRES: 6/30/03