


RECEIVED


SEP 18 2000

WATER RESOURCES DEPT.
SALEM, OREGON

1" = 1320'
T 6N, R 44E, WM

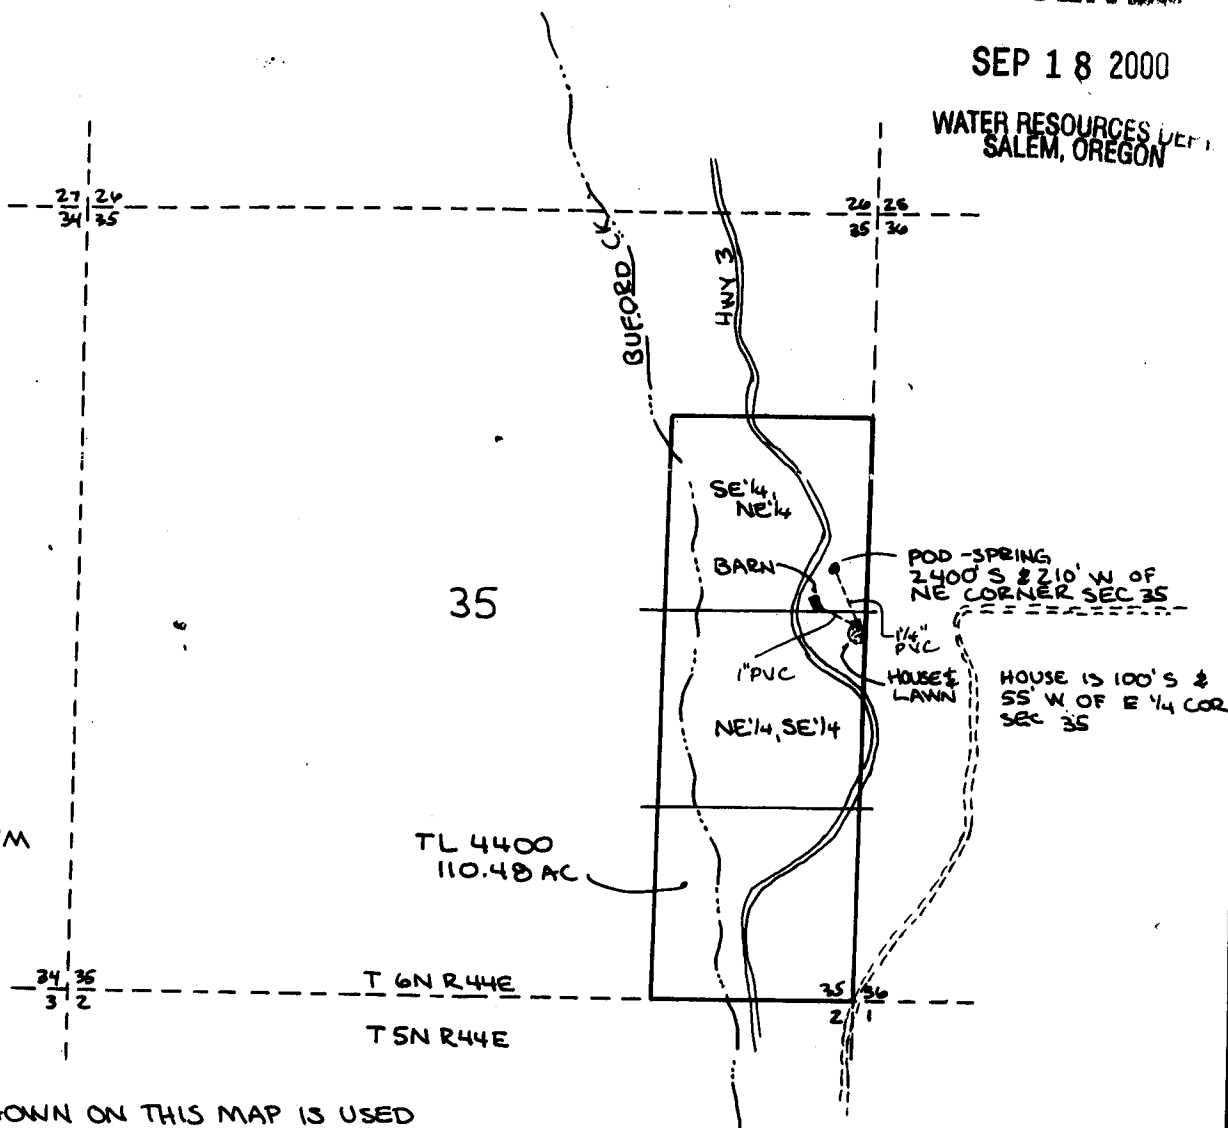

THE SPRING SHOWN ON THIS MAP IS USED FOR DOMESTIC USE IN THE HOUSE AND FOR IRRIGATING 1/10 ACRE LAWN, & FOR LIVESTOCK USE IN THE BARN AND WATER TROUGHS.

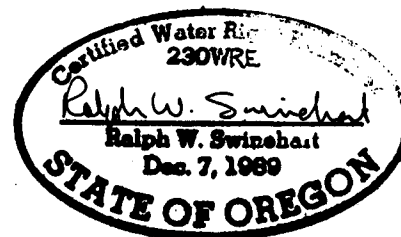

THIS MAP IS BASED ON USGS QUAD MAP, NRCS AERIAL PHOTOS, & FIELD MEASUREMENT. IT IS PREPARED FOR WATER RIGHT PURPOSES ONLY AND SHOULD NOT BE USED FOR PROPERTY LOCATION PURPOSES.

PERMIT #52906

FINAL PROOF MAP
EXPANDED DOMESTIC WATER RIGHT
FOR: MICHAEL & PATTIE GUSTAFSON
86085 LEWISTON HWY
ENTERPRISE, OREGON 97828
PH. 208-762-0955

PREPARED BY:
WALLOWA MOUNTAIN ENGINEERING
PO BOX 266
ENTERPRISE, OREGON 97828
PH 541-426-4085

9/5/2000