




SCALE: 1" = 400'

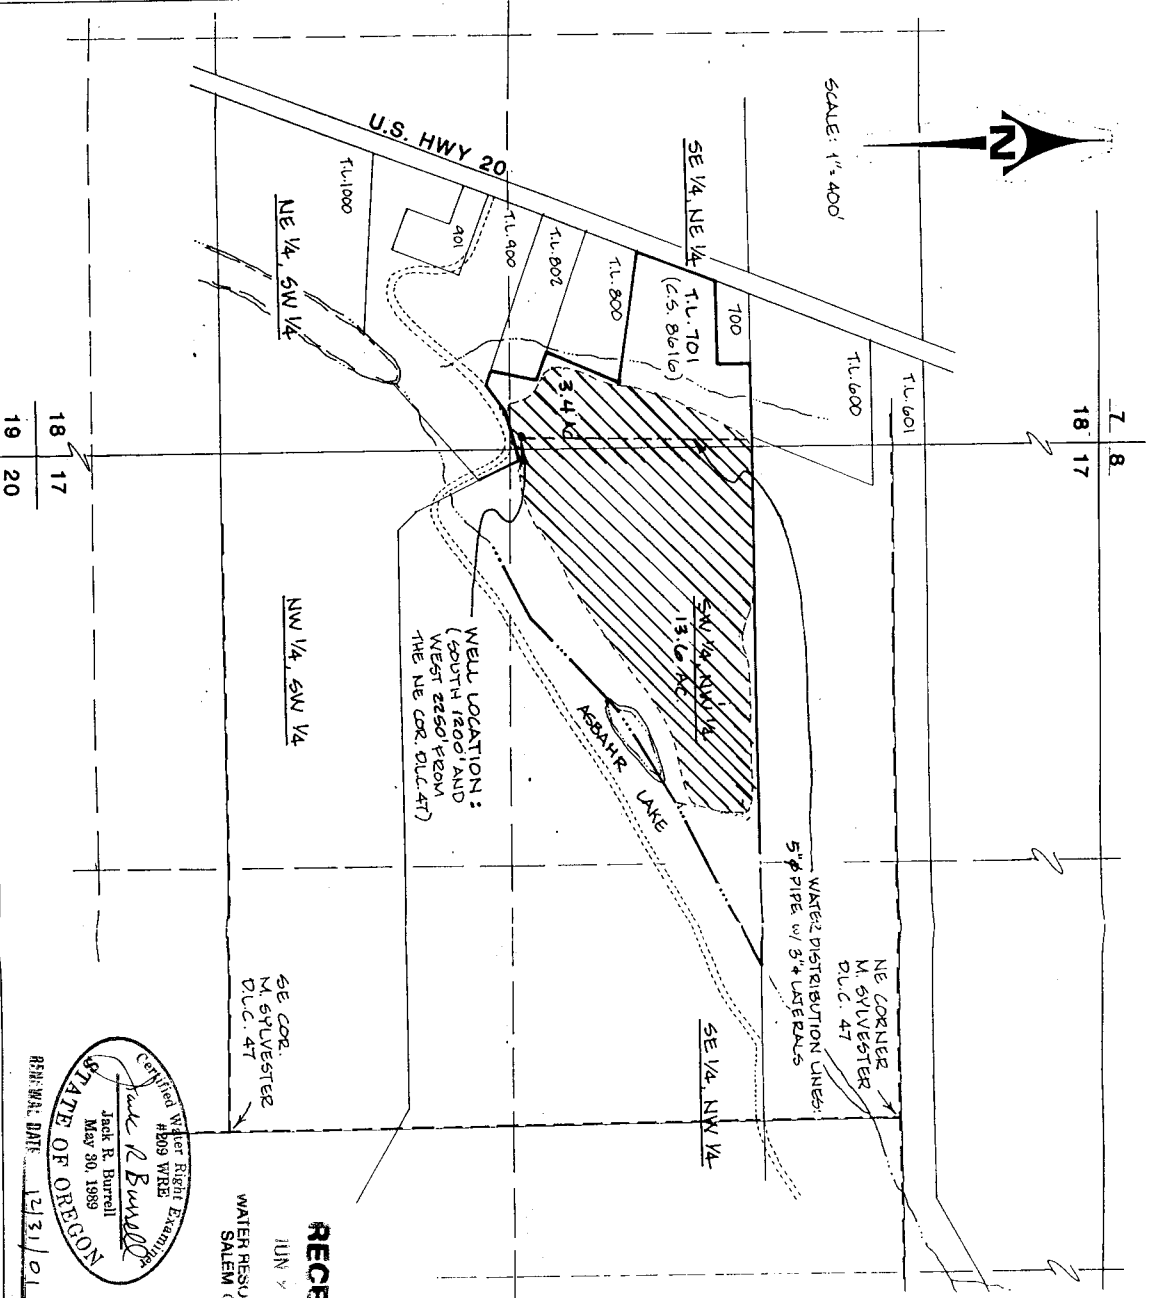

7 8  
18 17

18 17  
19 20

**KD**  
**ENGINEERING, INC.**  
 802 NW HICKORY STREET  
 POST OFFICE BOX 8785  
 ALBANY, OREGON 97381

**STARR WATER RIGHTS**  
 Sections 17 & 18, T.11 S., R. 4 W., W.M.,  
 BENTON COUNTY, OREGON

Certified Water Right Examiner  
 Jack R. Burrell  
 May 30, 1989  
 STATE OF OREGON  
 REF: WA. DATE: 12/31/01

**RECEIVED**  
 JUN 7 2001  
 WATER RESOURCES DEPT.  
 SALEM OREGON



PORTION OF PROPERTY TO BE IRRIGATED  
 IS DEFINED BY DIAGONAL HATCHING  
 17.0 acres

DSGN. BY: J.R. BURETTELL  
 DWG. BY: E.J.E.  
 CKD. BY: J.R.B.  
 SCALE: 1" = 400'  
 DATE: June 21, 2001  
 PROJECT NO.: 92-108  
 SHEET NO.  
**1 of 1**

Map of Beneficial Use  
 Under  
 APPLICATION T-8745

in the name of  
**STANLEY STARR, Selling Owner**  
 4691 S.W. Hollyhook Circle  
 Corvallis, OR 97333

**PATRICK & RHONDA HYNES, Receiving Owner**  
 4835 NW Hwy. 20  
 Corvallis, OR 97330

Date of Site Inspection: September 26, 2000  
 Date of Map: June 21, 2001

Tax Lot: 701 (114-17)  
 Source: A well in the Willamette River Basin.

**Area of Irrigation**  
 Under Certificate No. 36962, there are 17.0 acres being put to beneficial use as specified by quarter-quarter sections on the herein attached map.

I, JACK R. BURRELL, BEING DULY SWORN AS A WATER RIGHT EXAMINER, LICENSE NO. 209, HAVE PREPARED THIS MAP FOR STANLEY STARR ON THIS 21<sup>st</sup> DAY OF JUNE, 2001. THE AREAS HATCHED REPRESENT THE ACREAGE'S BEING IRRIGATED AT THE TIME OF THE SITE INSPECTION CONDUCTED ON SEPTEMBER 26, 2000.

PREPARATION OF THIS MAP IS FOR THE PURPOSE OF IDENTIFYING THE LOCATION OF THE WATER RIGHT ONLY AND HAS NO INTENT TO PROVIDE DIMENSIONS OR LOCATION OF PROPERTY OWNERSHIP LINES.

**LEGEND:**