


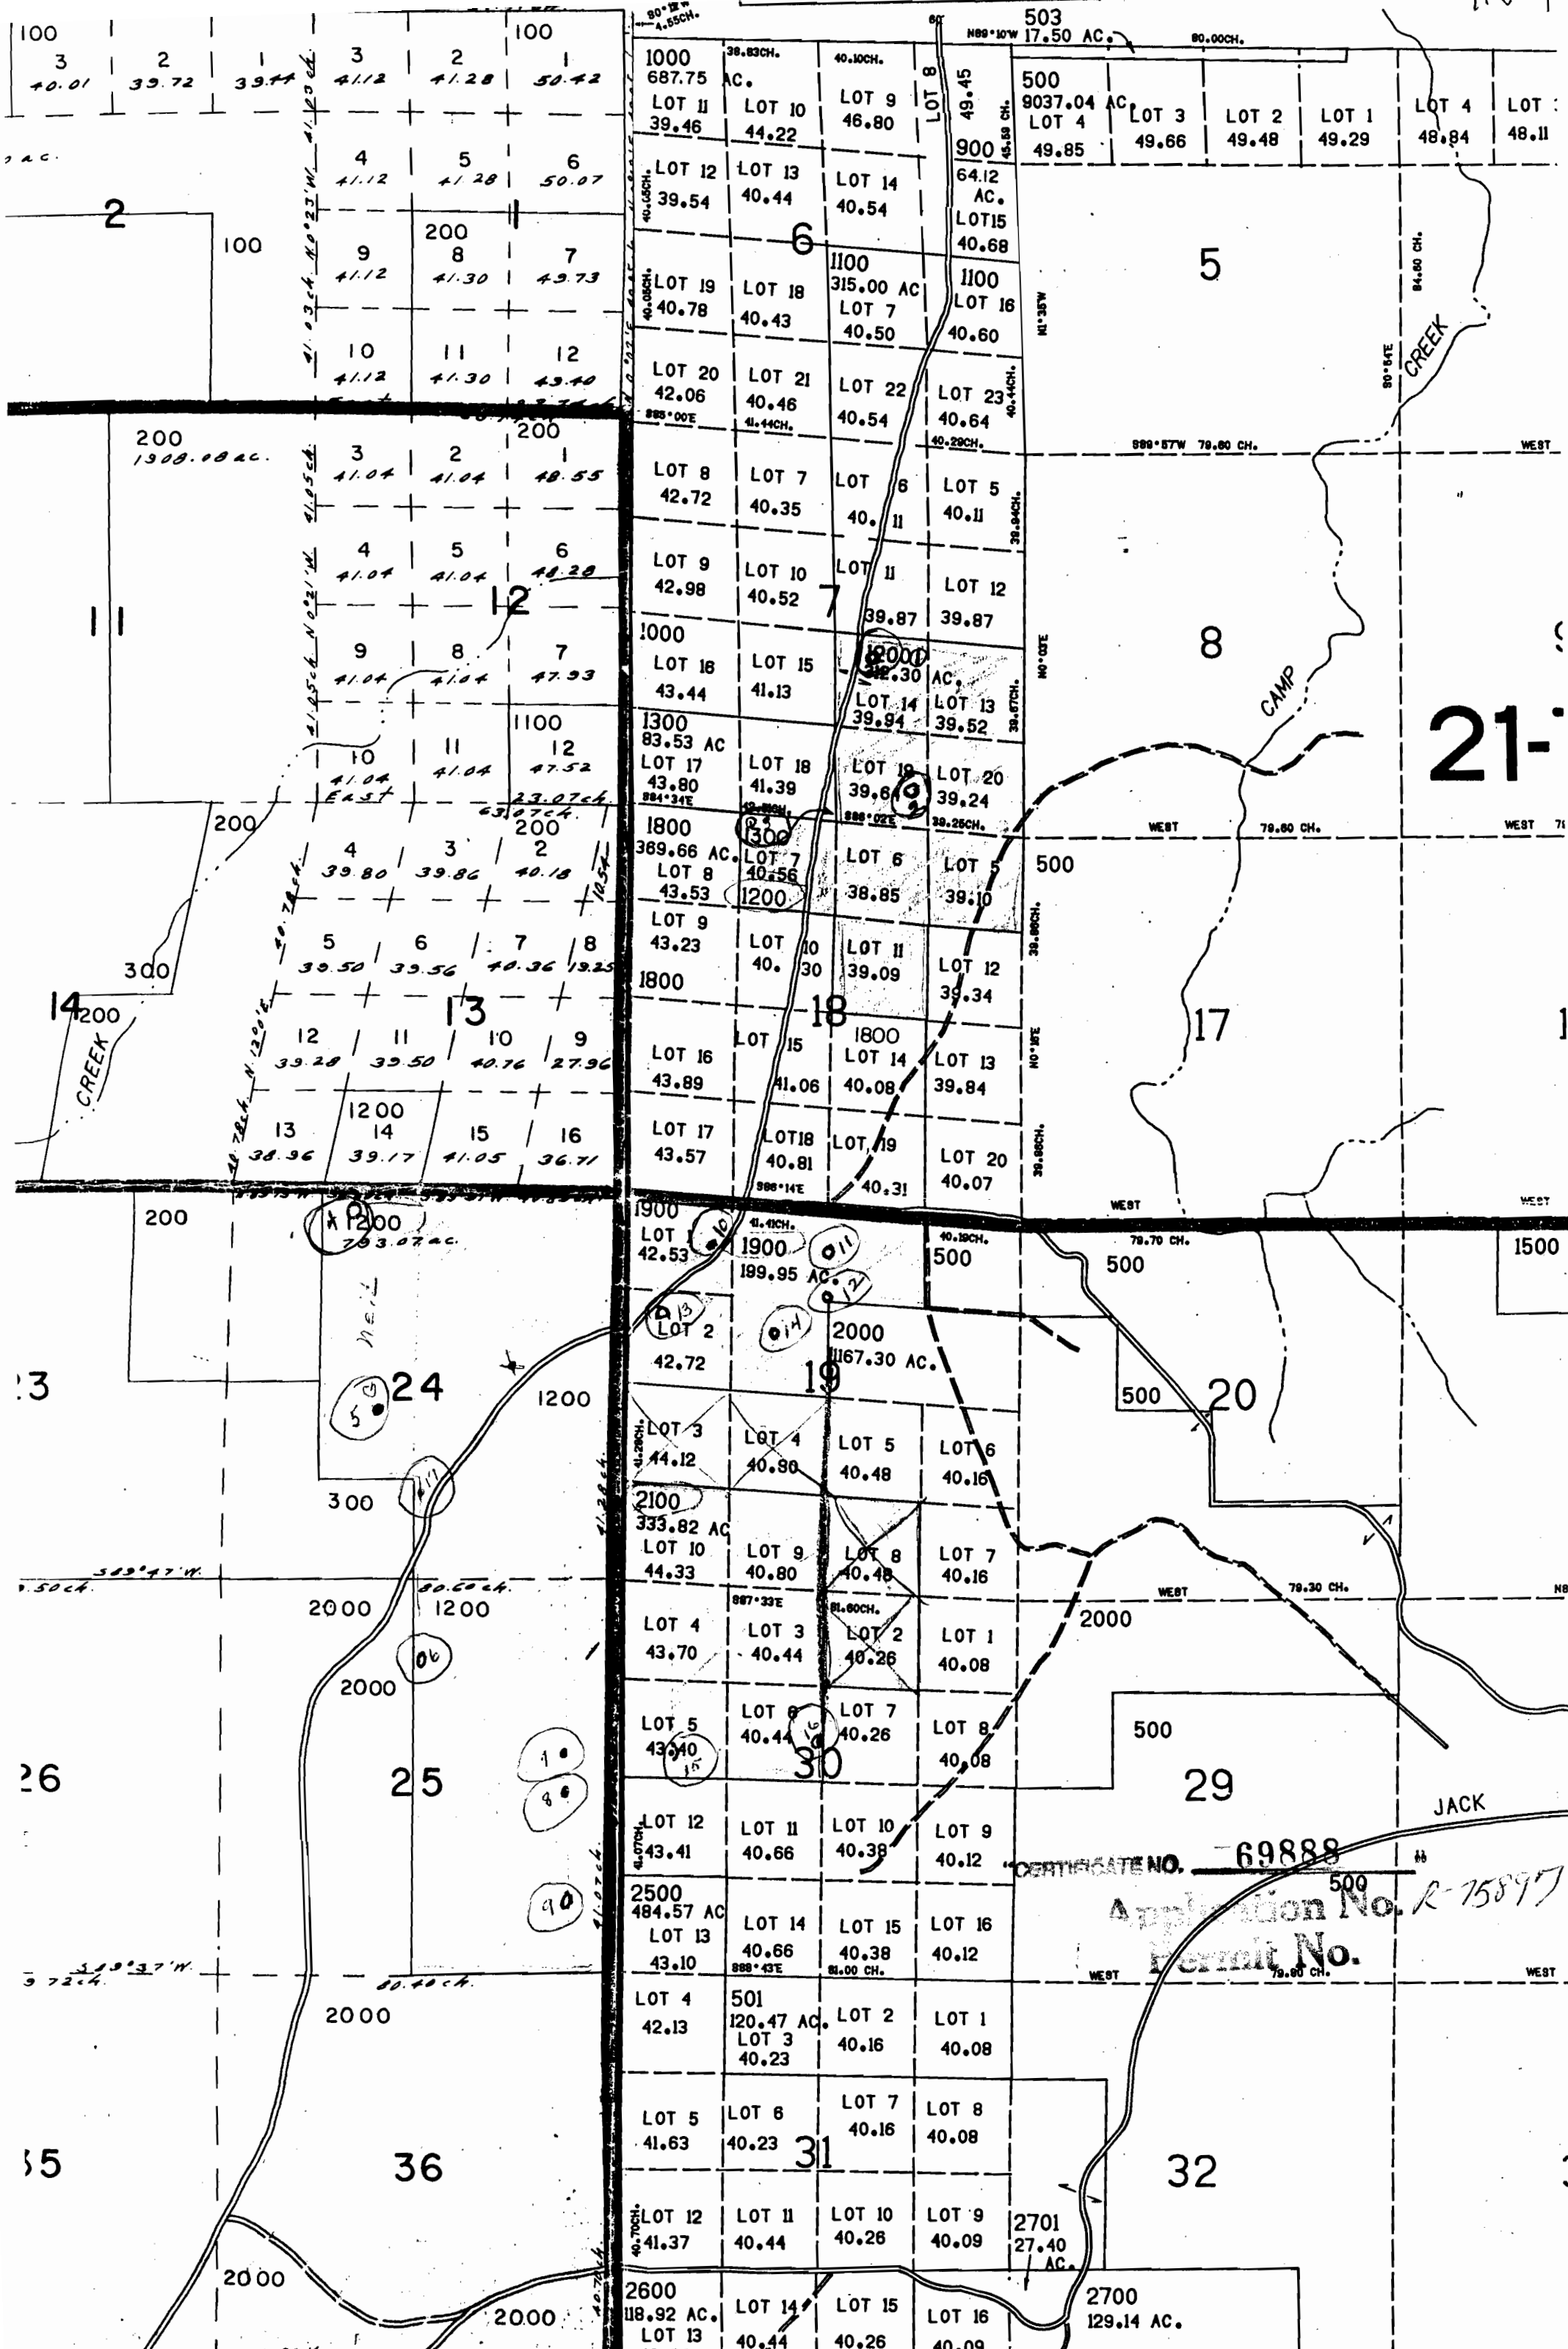

CERTIFICATE NO. 69888
Application No. R-75897
Permit No.