

T. 26 S., R. 13 W. W.M.

11757


MAP To Accompany Application of

H. L. WRIGHT.

for a permit to appropriate
water in Sec 11 and 14 Twp
26 S., R. 13 W. W.M. Coos Co. Ore.

I, D. L. Buckingham of
Marshfield, Oregon, do hereby
certify that this map was made
from notes taken by me during an
actual survey made Sept 13, 1927
and that it correctly represents
the works described in the accom-
panying application together with
the location of the streams in the
immediate vicinity

D. L. Buckingham

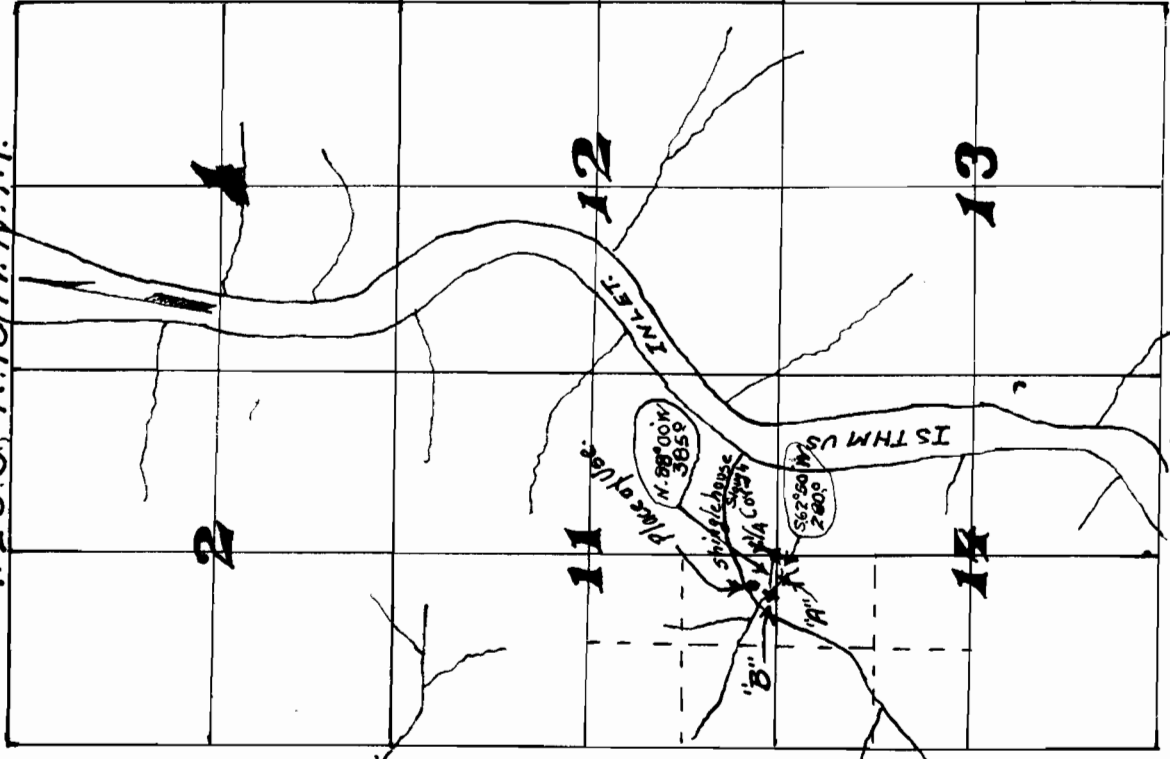

Scale
2 inches = one mile



Application No. 757

Draw. No.