


557727E

1" = 2000'
SEE MAP 4S 27

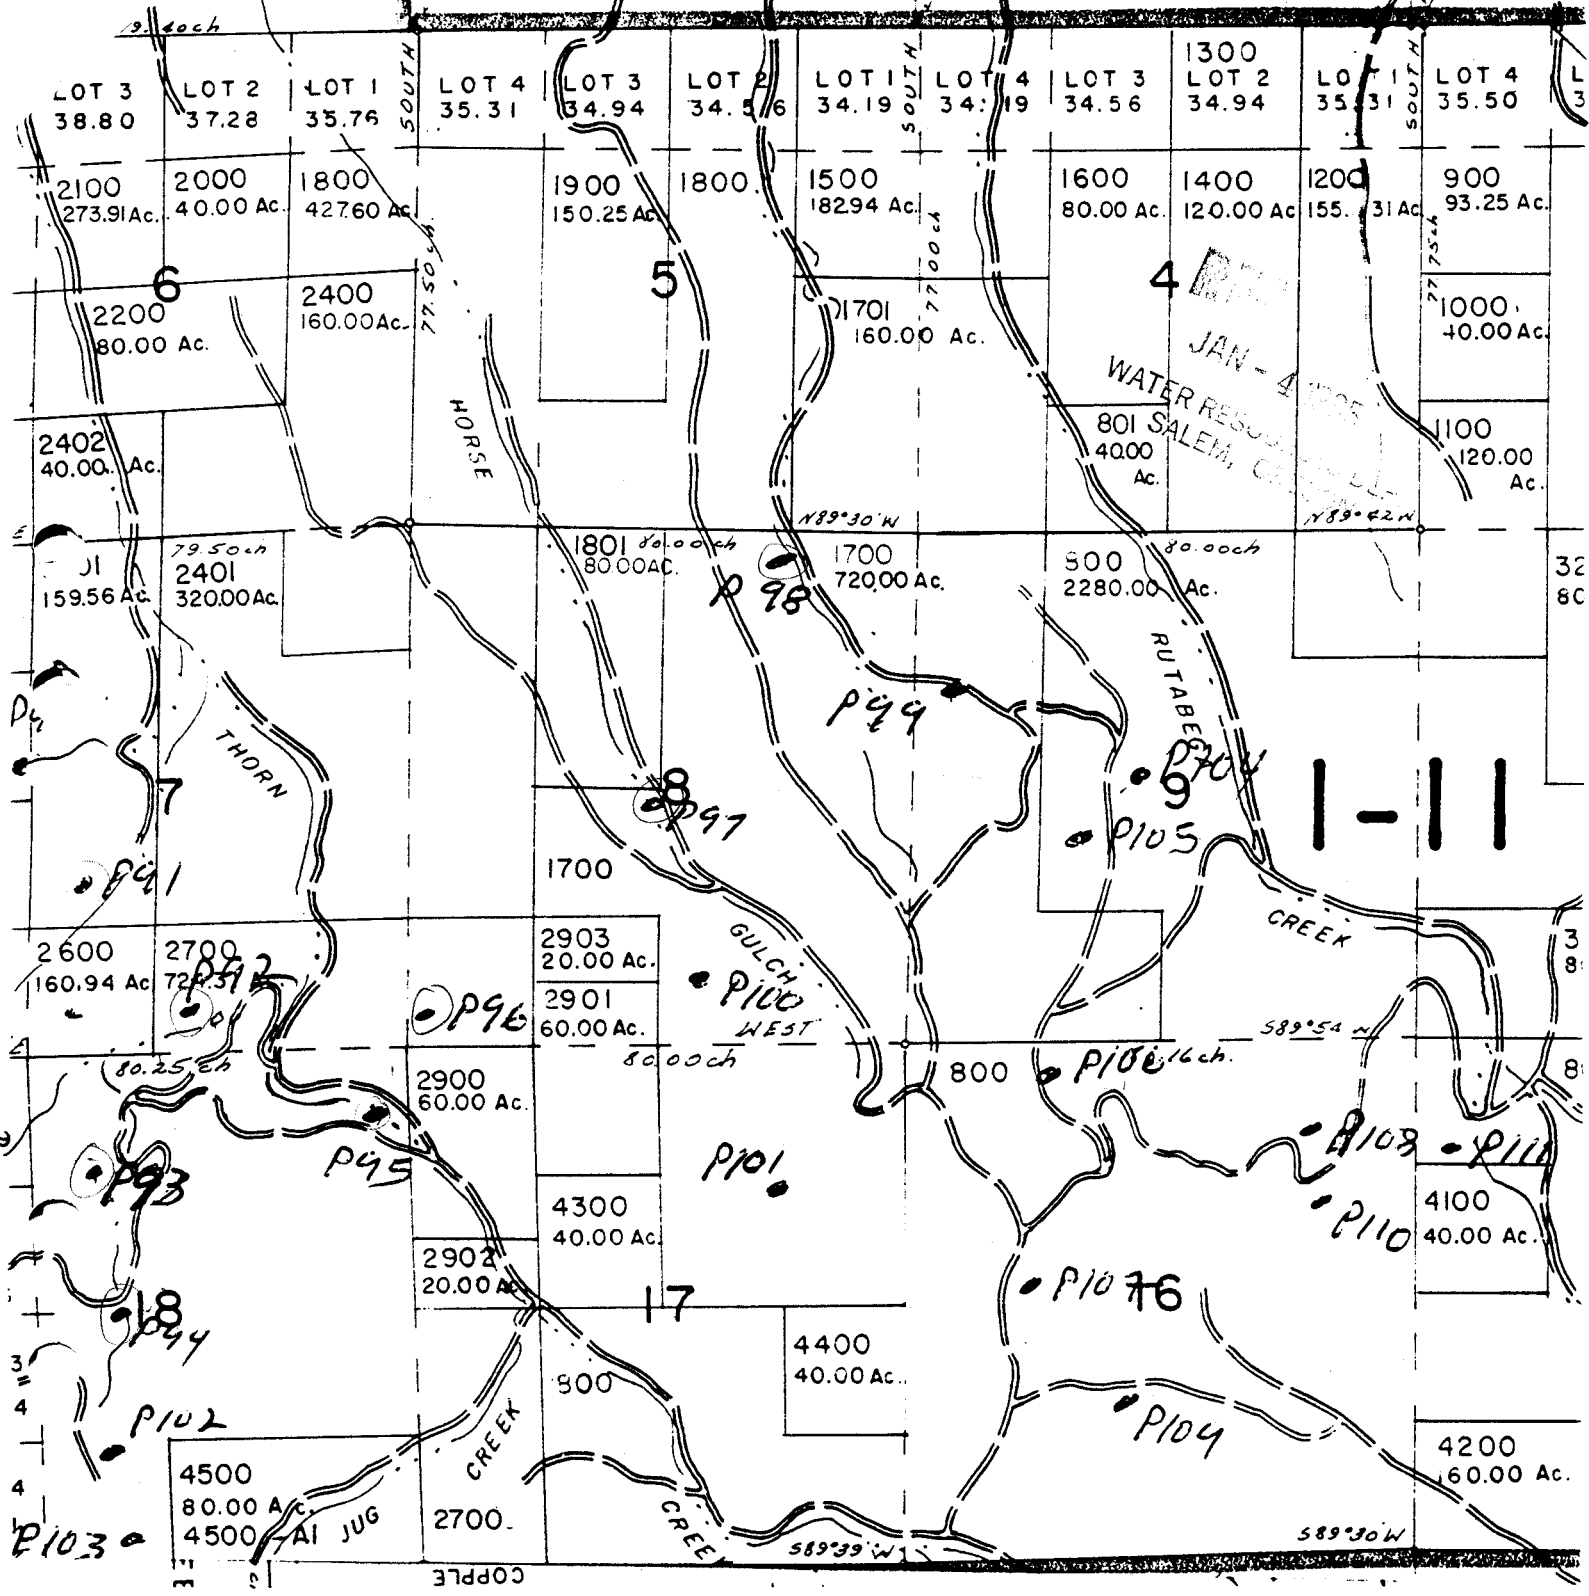

Application No. R. 79888
 Permit No. [REDACTED]