


R-80892, Certificate 79665

UNITED STATES  
DEPARTMENT OF THE INTERIOR  
GEOLOGICAL SURVEY

WILLIAMS PRAIRIE QUADRANG  
OREGON-CROOK CO.  
7.5 MINUTE SERIES (TOPOGRAPHIC)

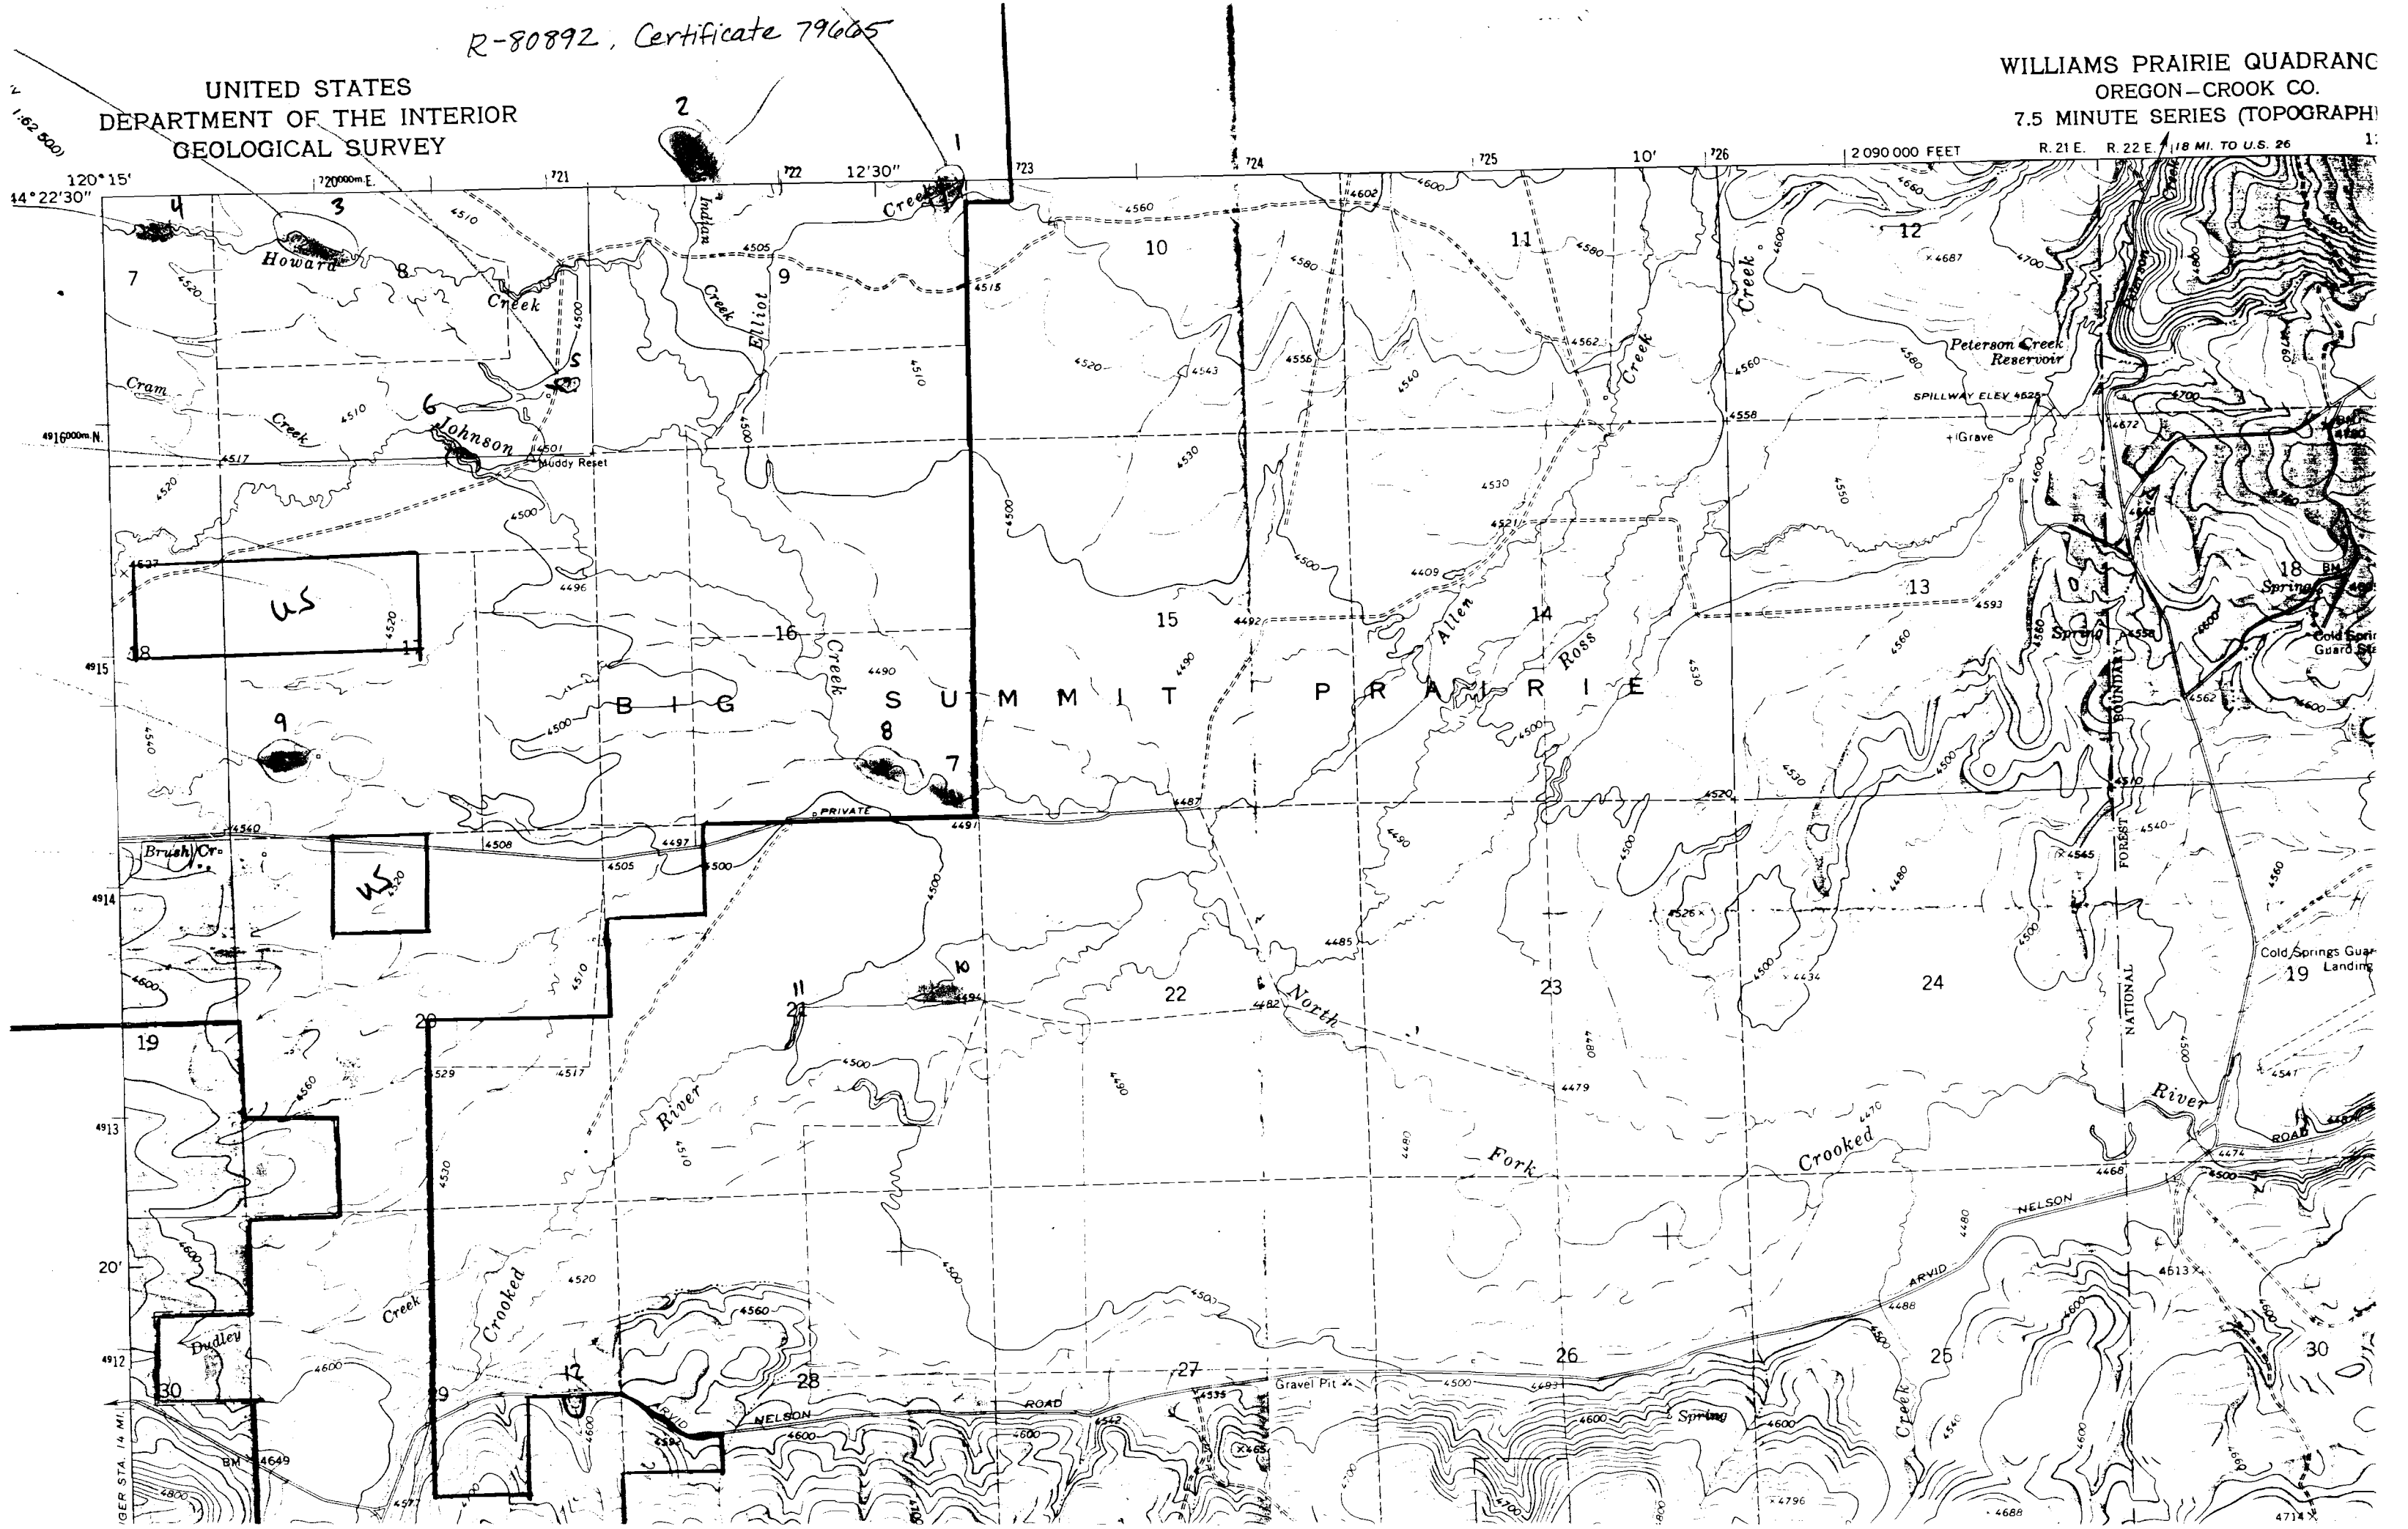

1:62,500  
120° 15'  
14° 22' 30"  
720000m.E.  
4916000m.N.  
GER STA. 14 MI.

2 090 000 FEET  
R. 21 E. R. 22 E. 18 MI. TO U.S. 26  
1: