

MALHEUR NATIONAL FOREST

STOCK WATER (Le III)


Map 1 of 2
Long CR allotment

FS Temporary Id. # 83437
SCALE 4 IN. : 1 MILE

T. 12 S. R. 32 E. North

application no. 66808

permit no. 50050

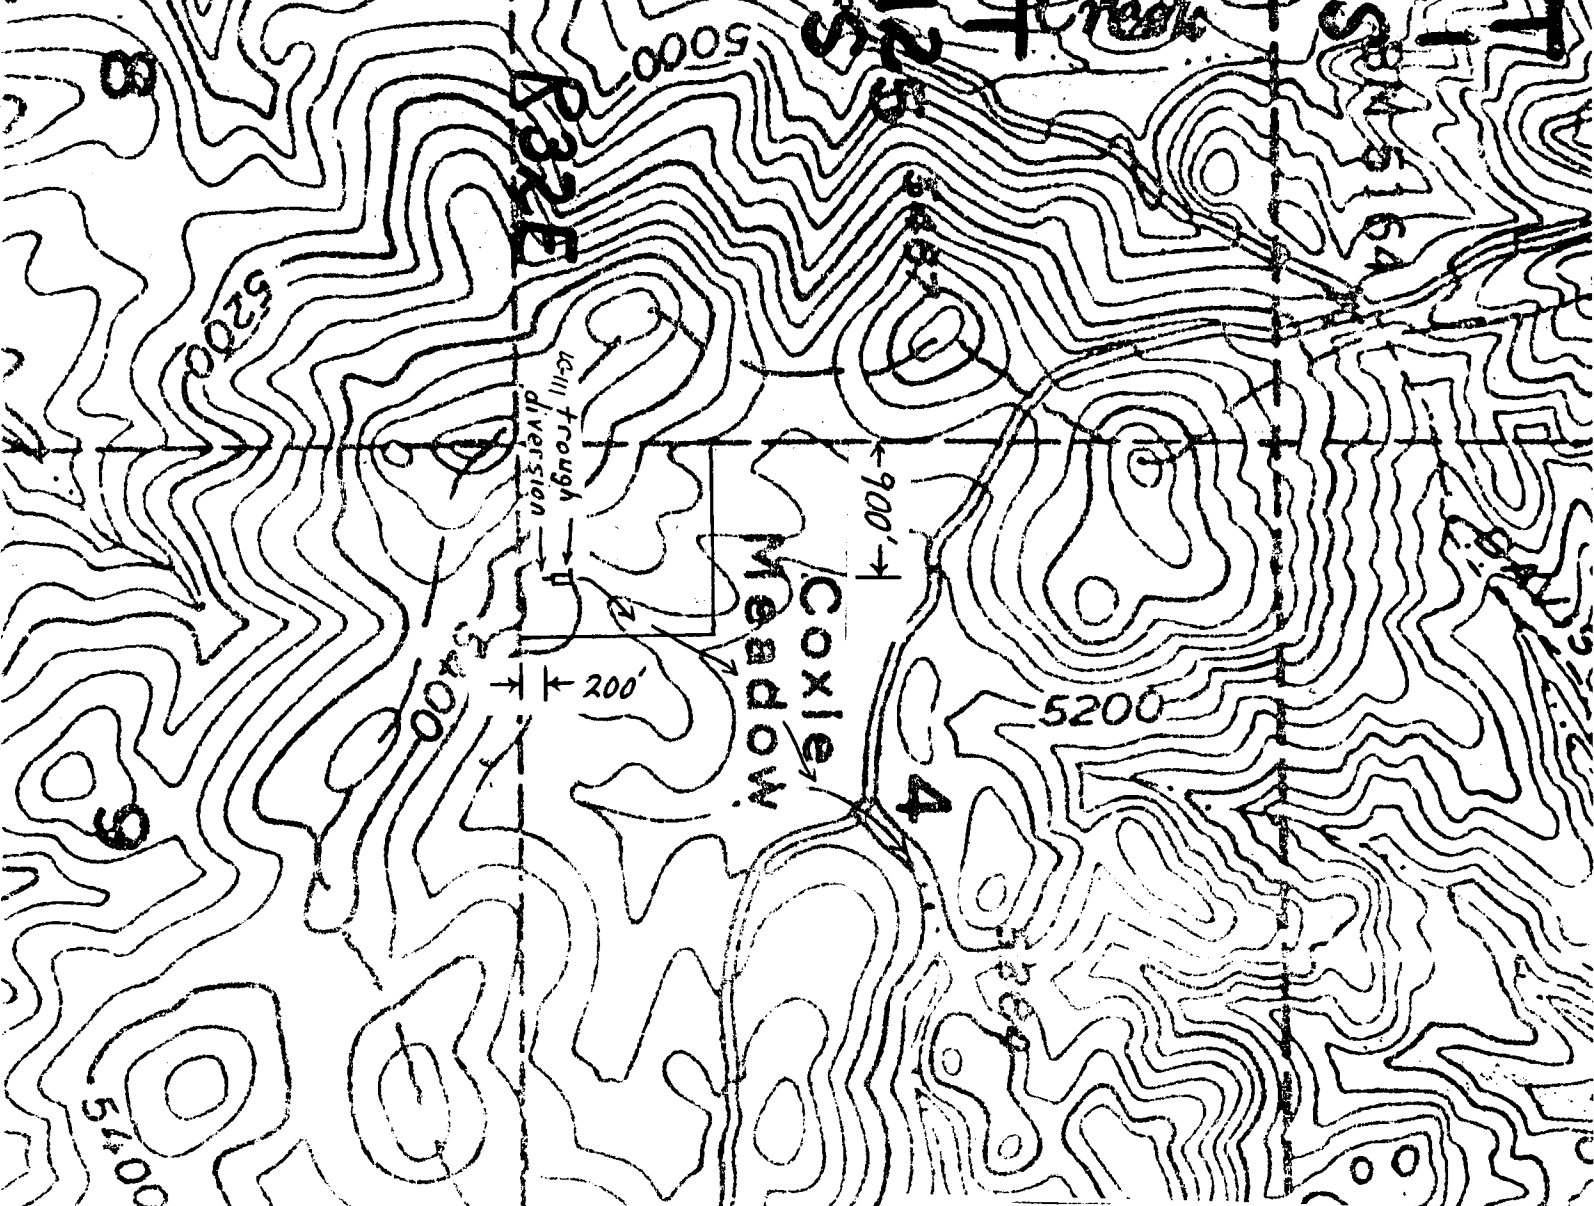

RECEIVED
SEP 26 1983
