


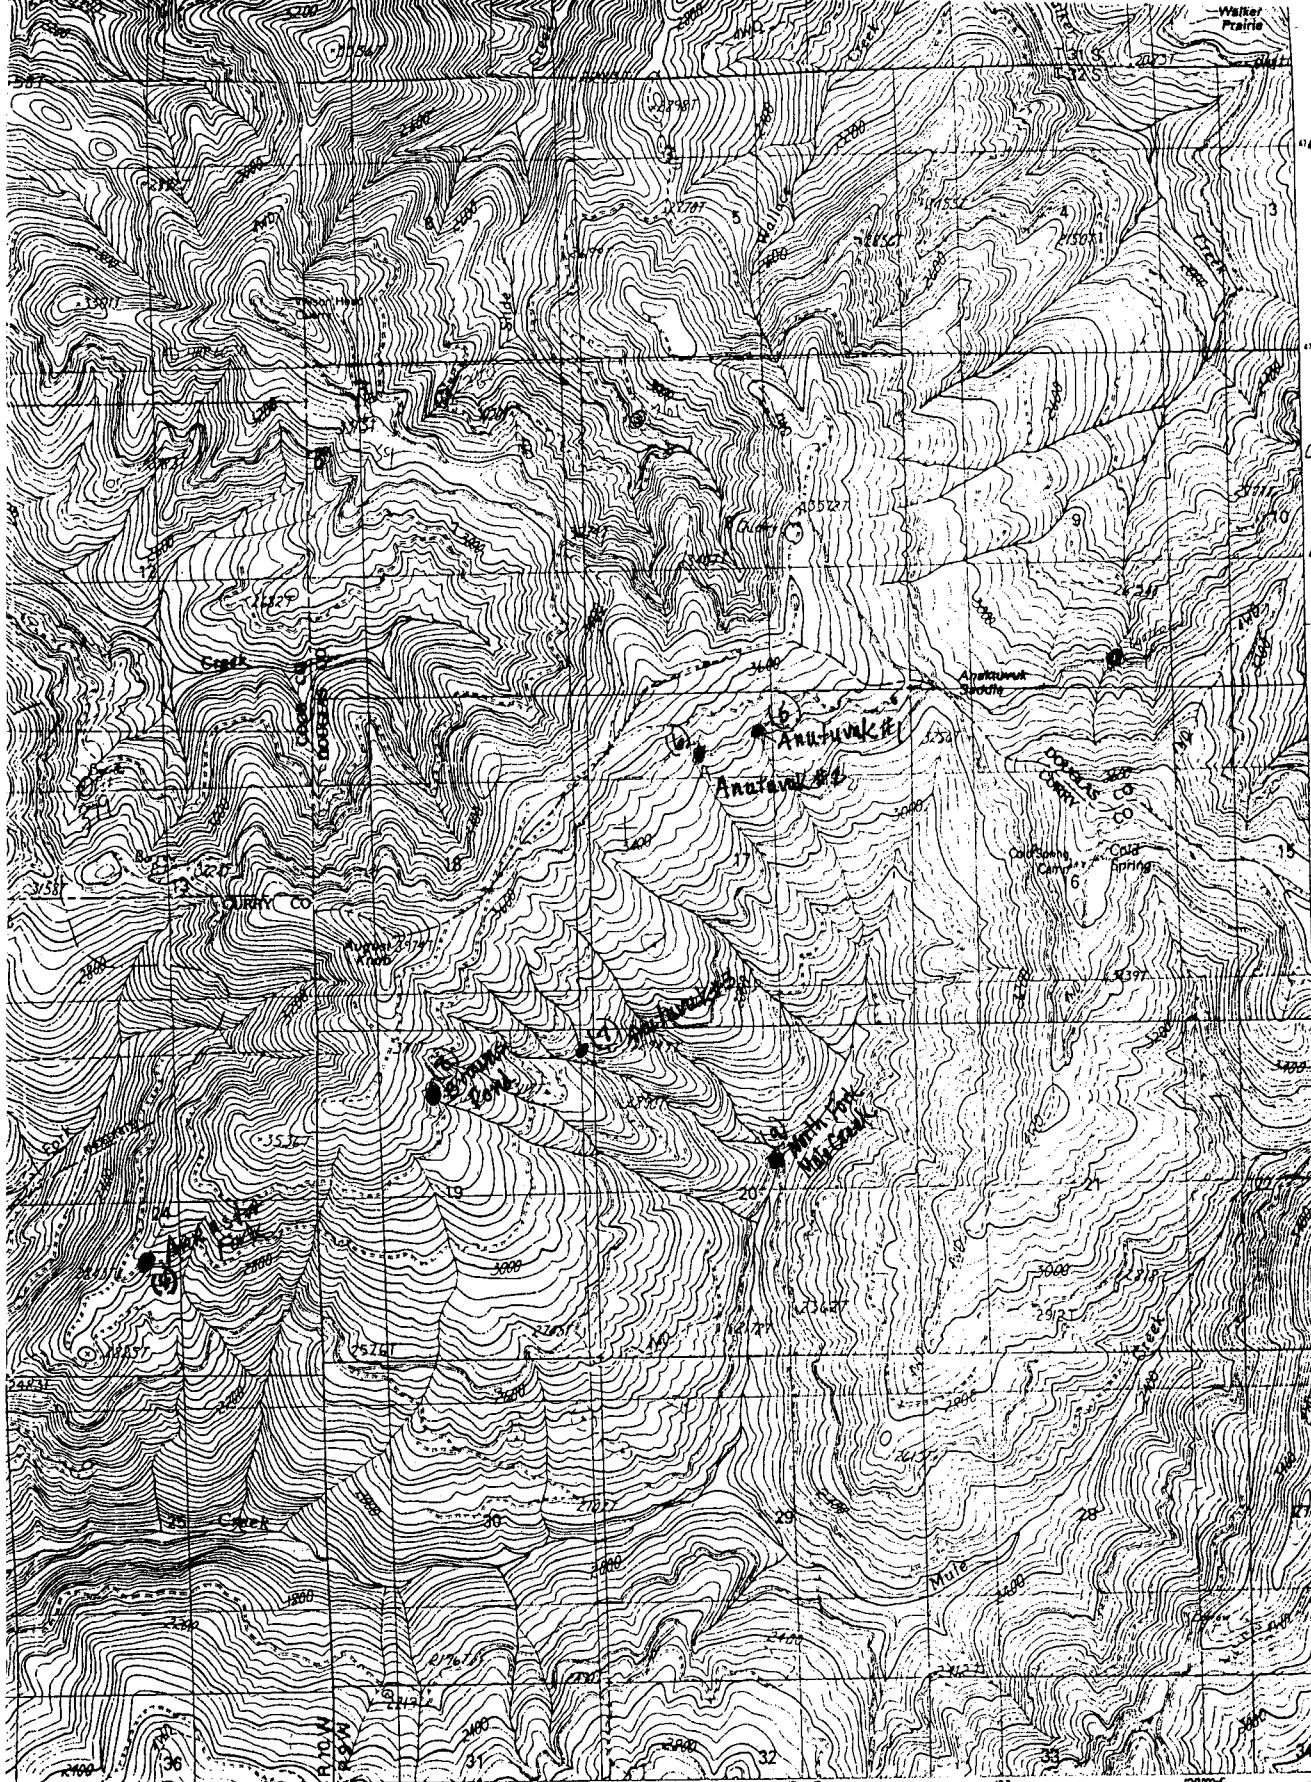


SCALE 1:24 000

Application No. **26850**
 Permit No. **71376**

Arrasta Fork PC,

ROAD LEGEND

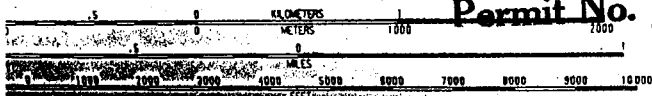

CERTIFICATE NO. **71376**

QUADRANGLE LOCATION

Improved Road
 Unimproved Road
 Trail

Interstate Route U.S. Route State Route

BONE Mtn. SE
 MOUNT BOLIVAR, OREGON

PROVISIONAL EDITION 1950


Working Map p.3

1	2	3
4	5	6
7	8	9

1. Rattle Creek
2. River Plume
3. Chisholm Ridge
4. Eden Valley
5. Dutchman Butte
6. Plural
7. Kelley Peak
8. Boulder Creek

CONTOUR INTERVAL 40 FEET
 (USGS) 1:250,000 Series
 (USGS) 1:250,000 Series

UNITED STATES GEOLOGICAL SURVEY, WASHINGTON, D.C. 20540

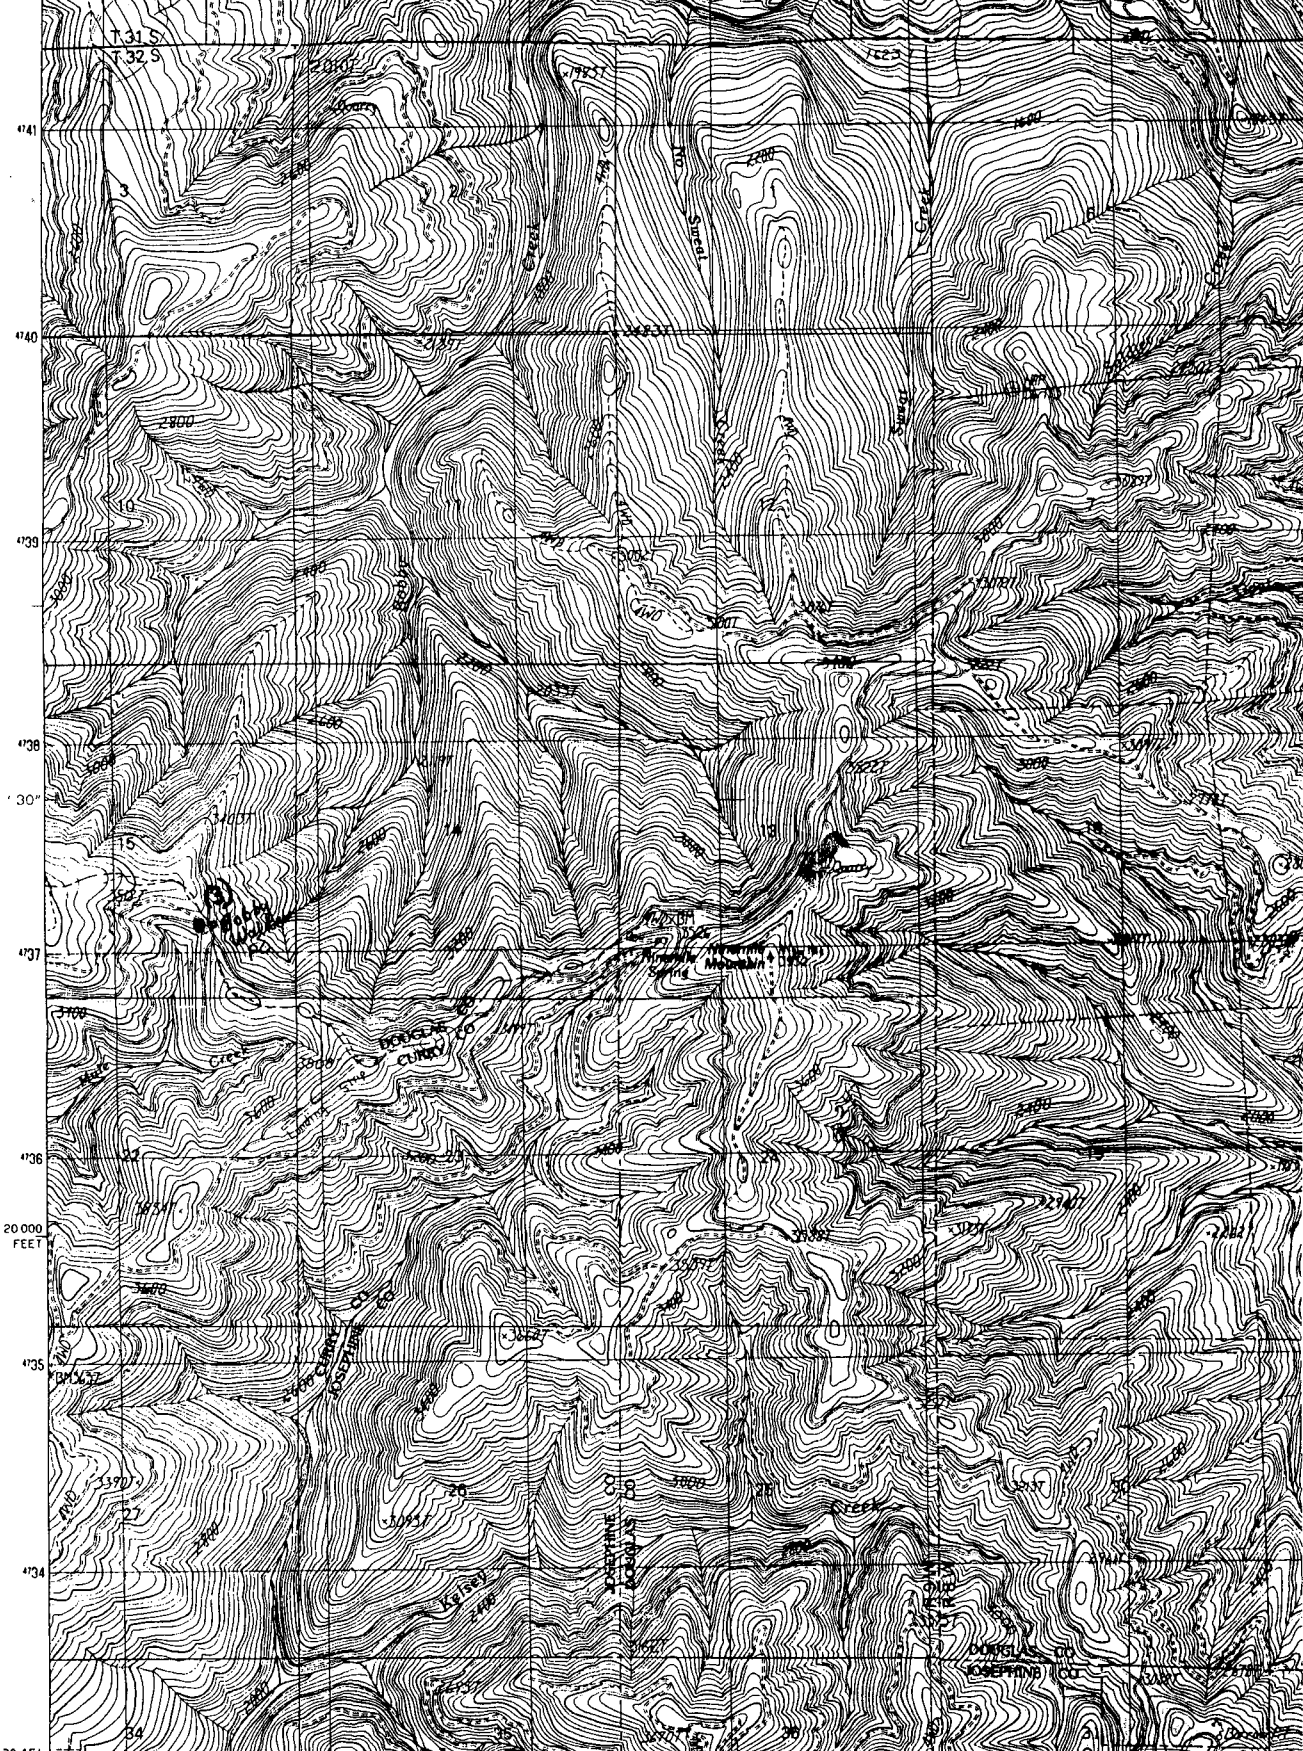

Application No. 2-78850
Permit No. 74376

PRODUCED BY THE UNITED STATES GEOLOGICAL SURVEY
CONTROL BY MAPS 1964
COMPILED FROM AERIAL PHOTOGRAPHS 1964
FIELD CHECKED 1968 MAP EDITED 1990
PROJECTION LAMBERT CONFORMAL CONIC
GRID: 800-METER UNIVERSAL TRANSVERSE MERCATOR ZONE 10
8000-FOOT STATE GRID TICKS OREGON SOUTH ZONE
UTM GRID DECLINATION 0° 20' WEST
1990 MAGNETIC NORTH DECLINATION 16° EAST
VERTICAL DATUM NATIONAL GEODETIC VERTICAL DATUM OF 1929
HORIZONTAL DATUM 1927 NORTH AMERICAN DATUM
To place on the predicted North American Datum of 1983,
move the projection lines as shown by dashed corner ticks
(21 meters north and 97 meters east)
There may be private inholdings within the boundaries of any
Federal and State Reservations shown on this map
No distinction made between houses, barns, and other buildings

CERTIFICATE NO. 79270

PROVISIONAL MAP
Produced from original
manuscript drawings. Infor-
mation shown as of date of
photography. 1

Bobby Walker P.C.
74376

SCALE 1:24,000
0 1000 2000 3000 4000 5000 6000 7000 8000
METERS
0 1000 2000 3000 4000 5000 6000 7000 8000
FEET

Dutchman Butte
Dutchman Butte SW

UNITED STATES GEOLOGICAL SURVEY
To convert meters to feet multiply by 3.2808
FOR SALE BY U.S. GEOLOGICAL SURVEY, DENVER, COLORADO 80221
OR, RESTON, VIRGINIA, 22092

Working Map p.2

Application No. R-78850
Permit No.

STATES "CERTIFICATE NO.
THE INTERIOR
SURVEY

Scale 1-24, 000

Four mile PC

Mar'ial NE

KELSEY PEAK QUADRANGLE
OREGON

7.5 MINUTE SERIES (TOPOGRAPHIC)

Working Map p.1

