


Application No. 71375
Permit No. 79671

CERTIFICATE NO. 79671

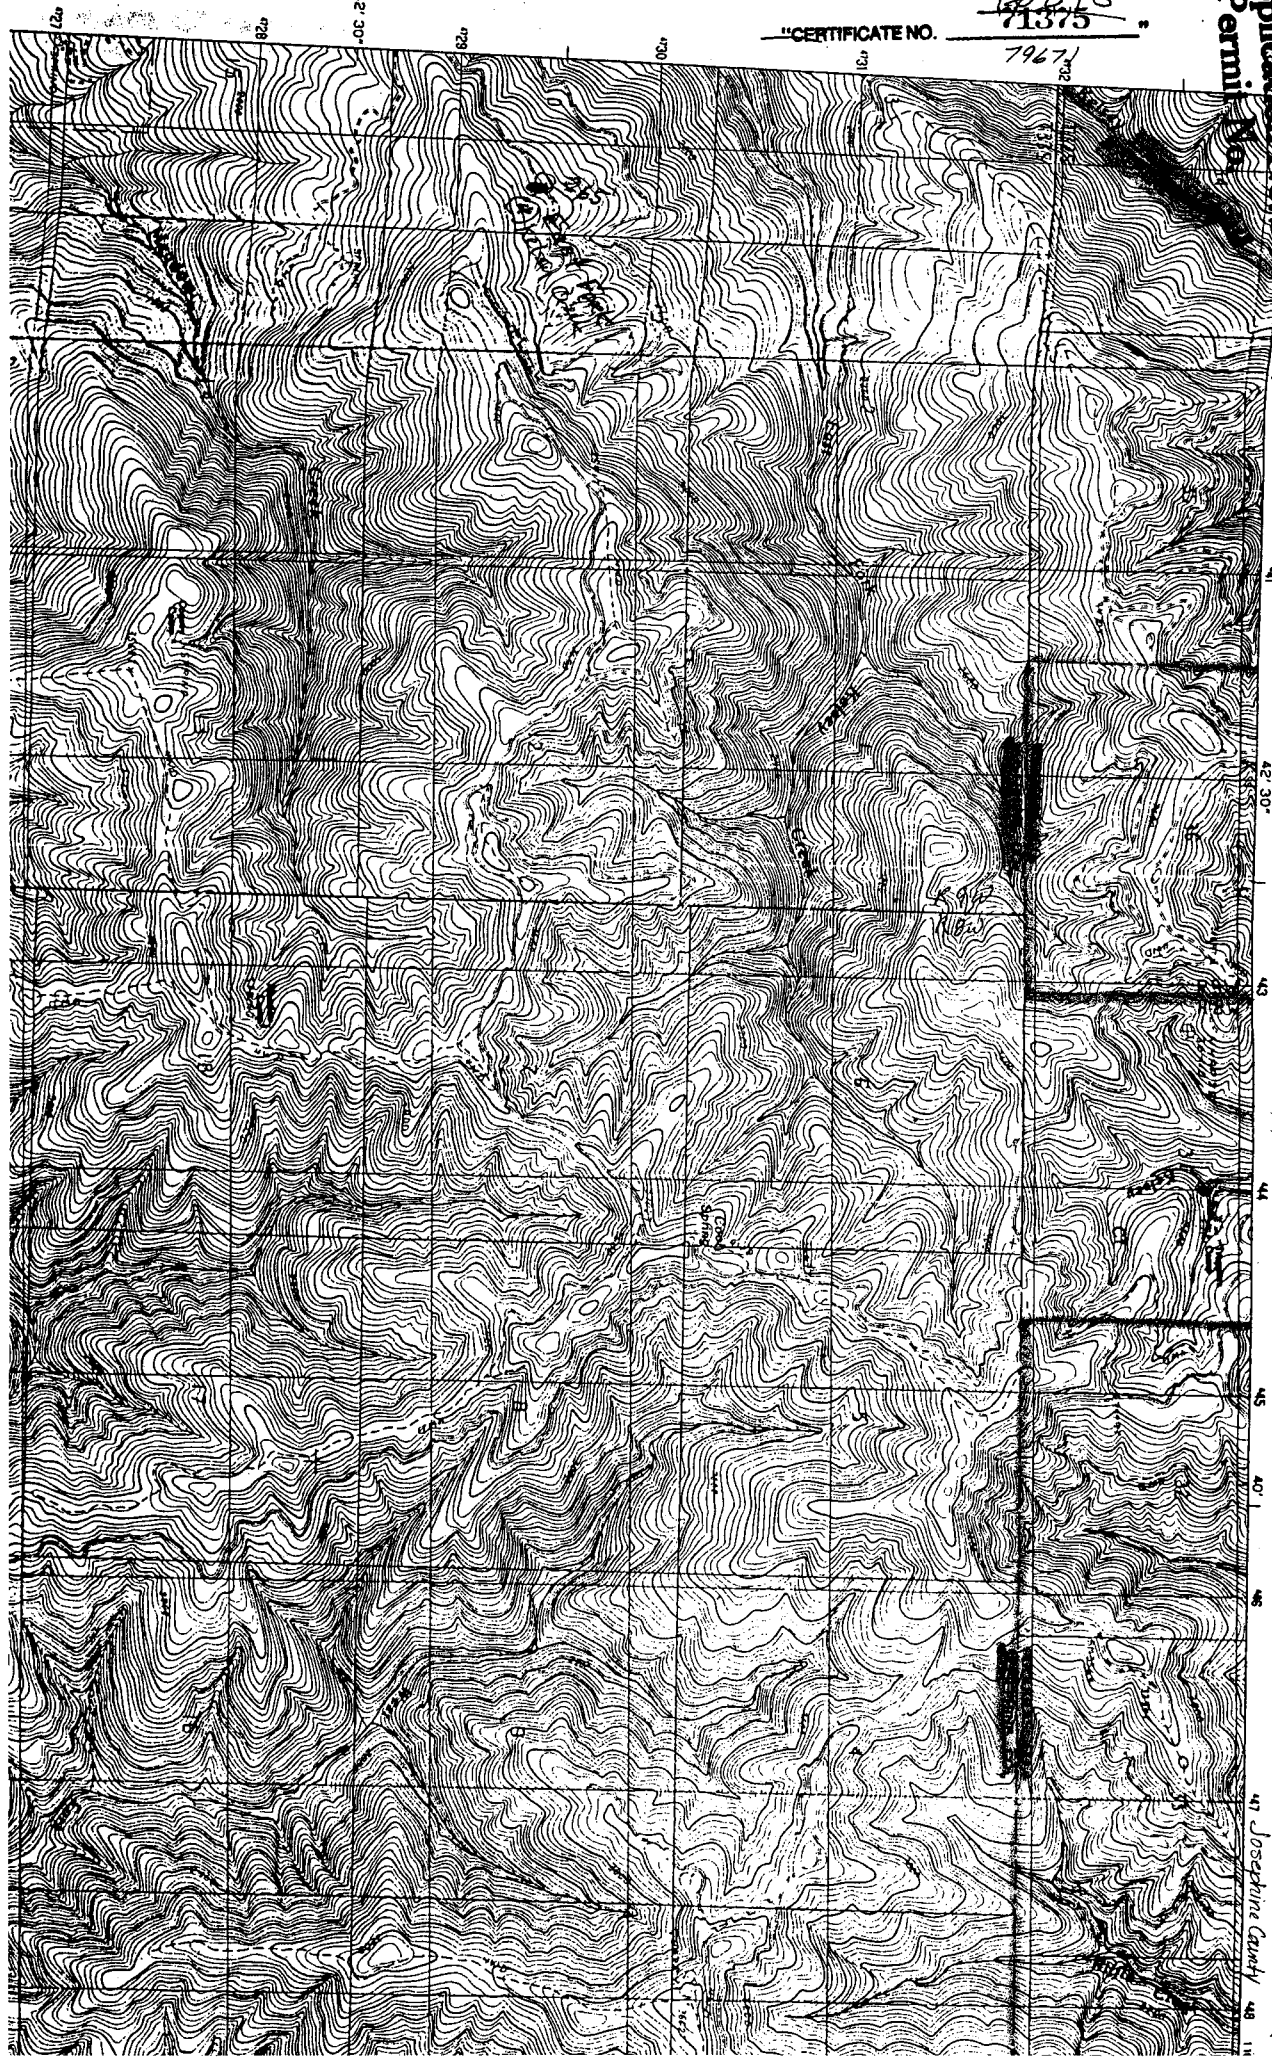

East Fork Kelsey Creek PC Scale - 1-24000

Section 14 W
Bunbar Creek Quad

7.5 MINUTE SERIES
OREGON

Application No. K-78948
Permit No.

"CERTIFICATE NO. 21375 79671
UNITED STATES
DEPARTMENT OF THE INTERIOR
GEOLOGICAL SURVEY

Scale - 1-24000

Quail Creek Burn P.C.

MANVEL NE
KELSEY PEAK QUADRANGLE
OREGON
7.5 MINUTE SERIES (TOPOGRAPHIC)

Working map p. 1

Curry County

