



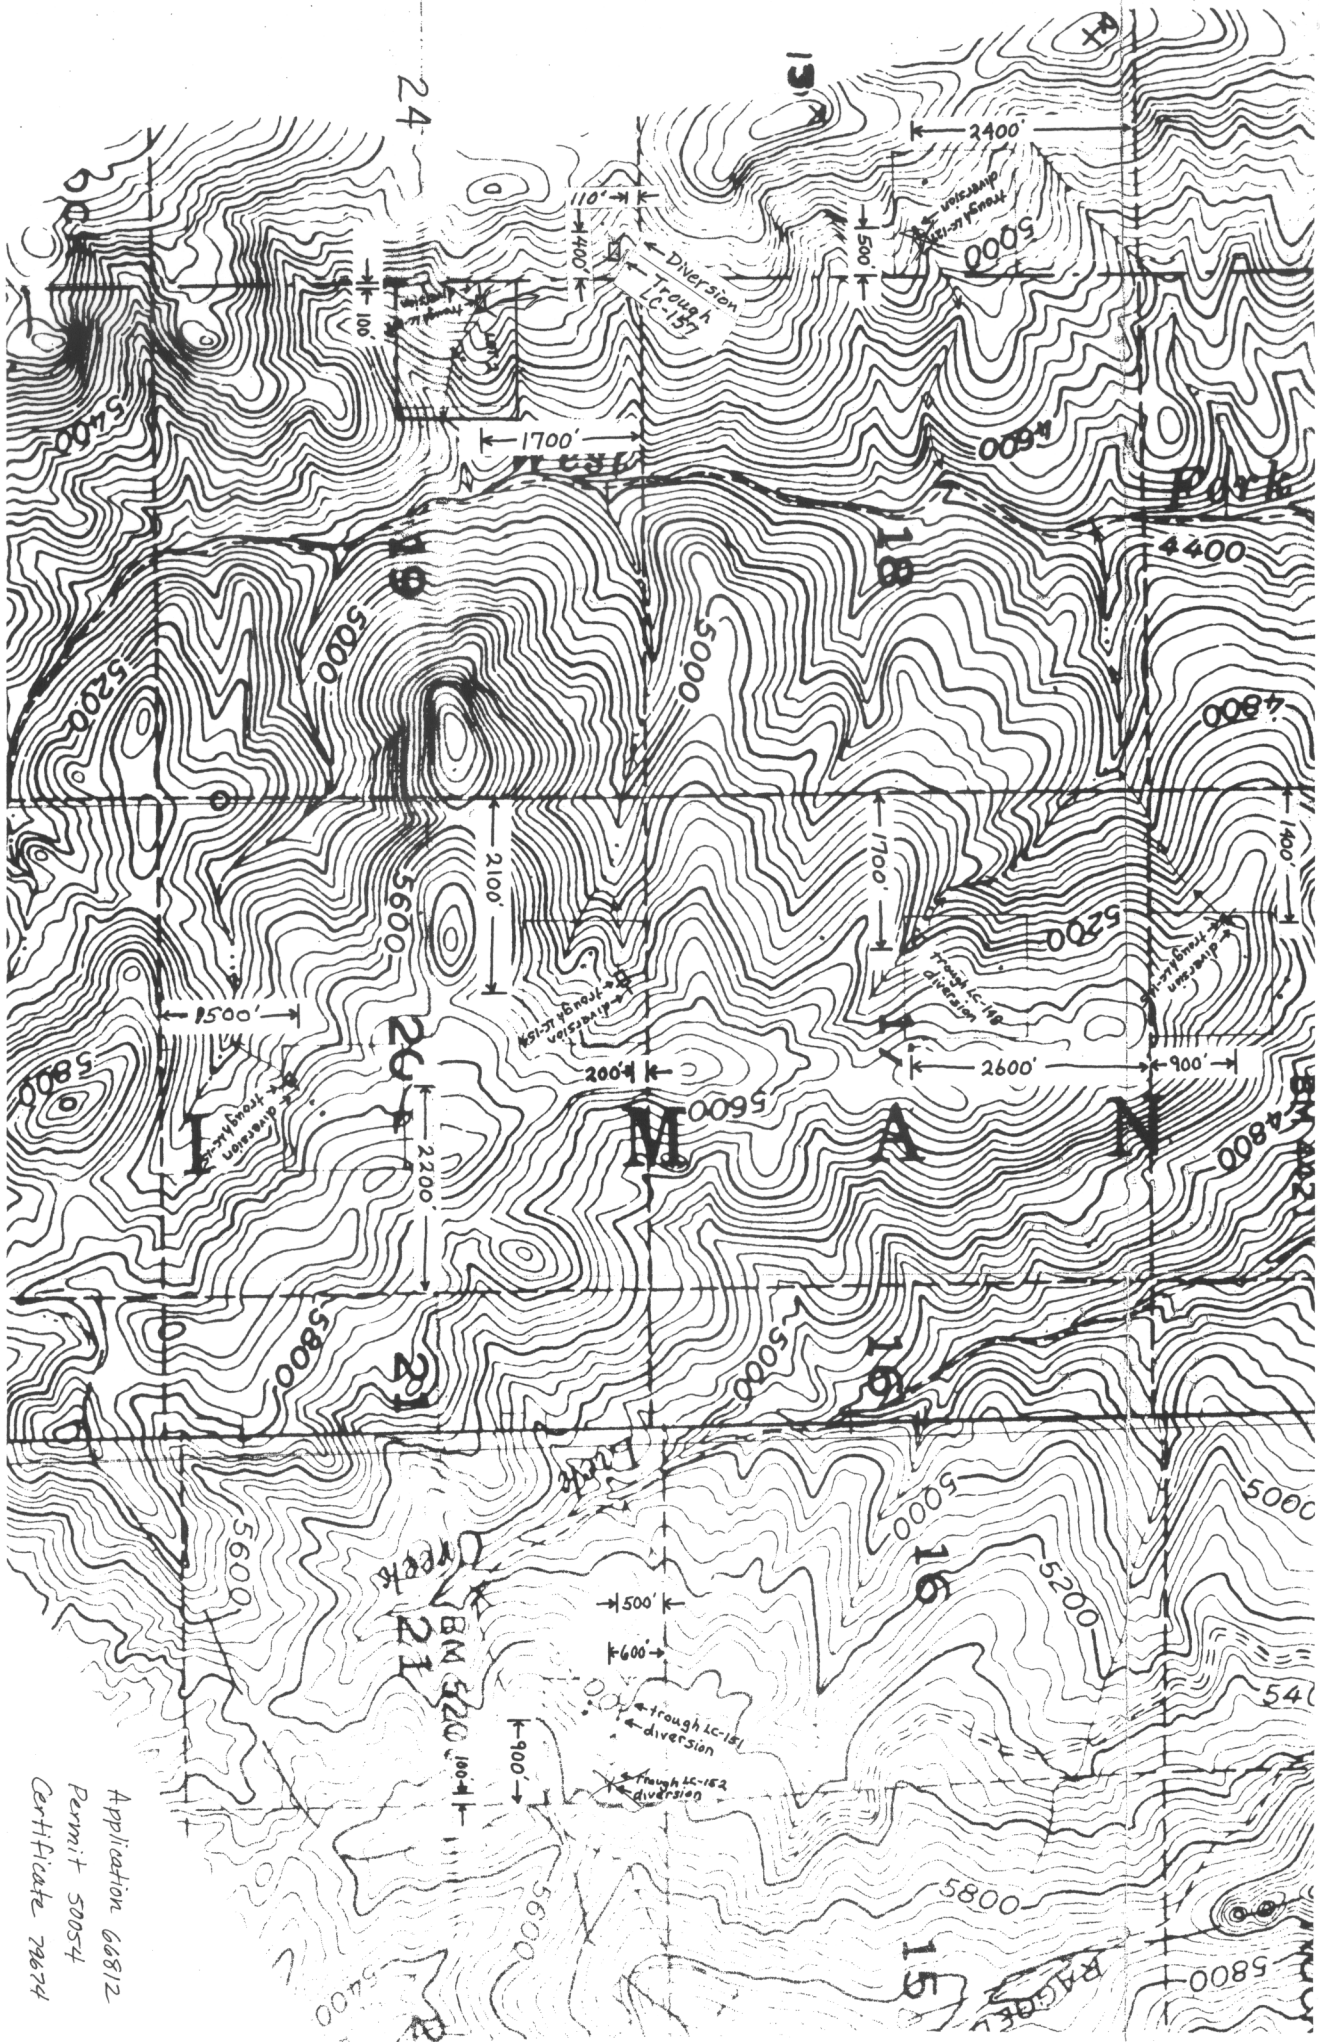

Application 66812
Permit 50054
Certificate 79674

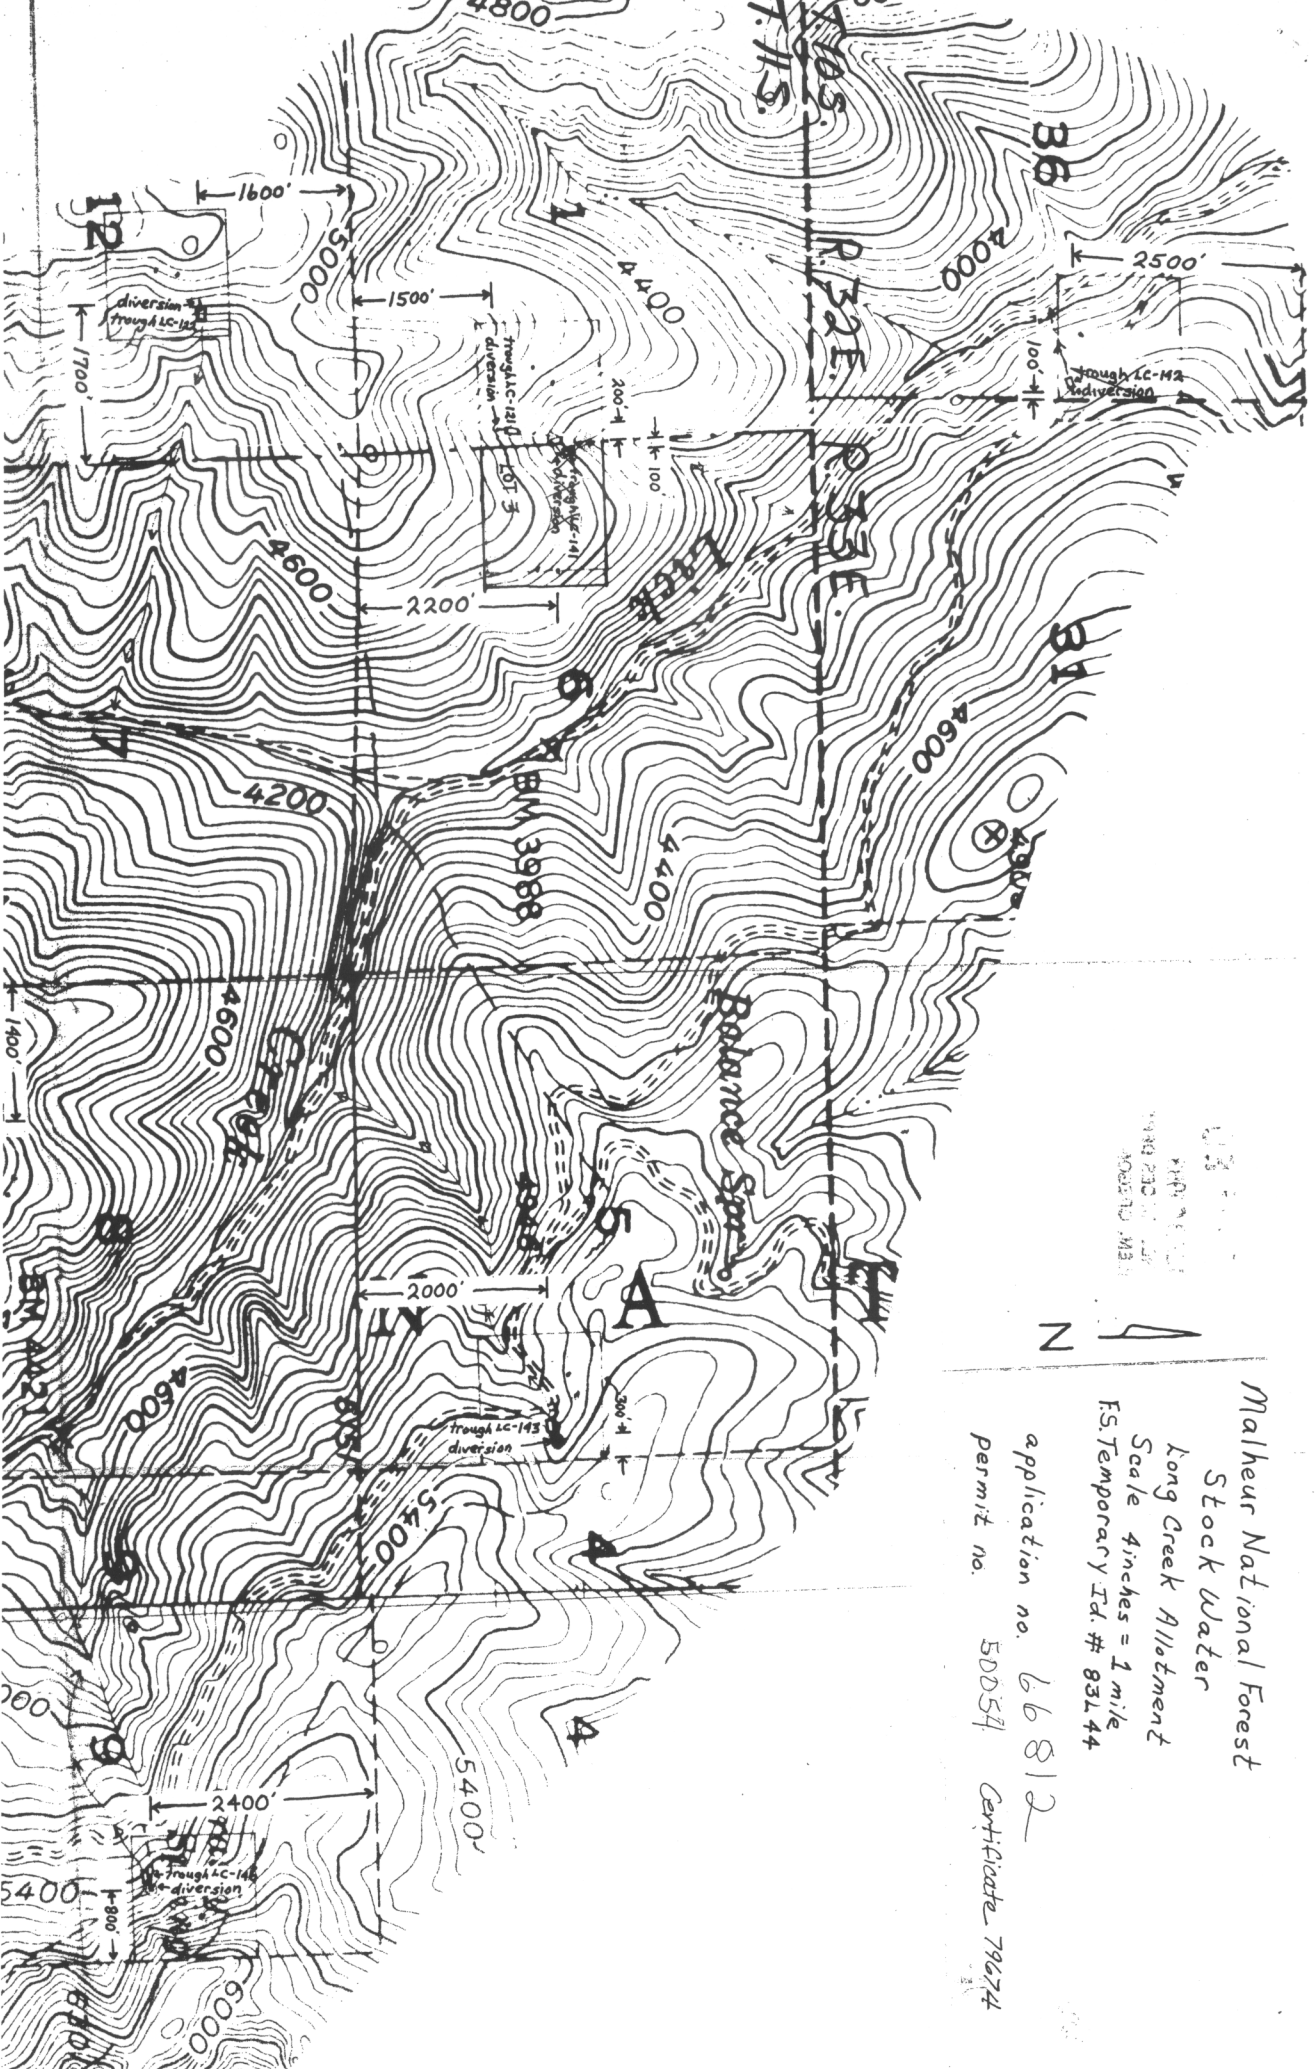

Malheur National Forest
Stock Water
Long Creek Allotment
Scale 4 inches = 1 mile
FS Temporary Id. # 83L44
application no. 66812
permit no. 50054 Certificate 79674