


T.2N.,R.12E.,W.M.

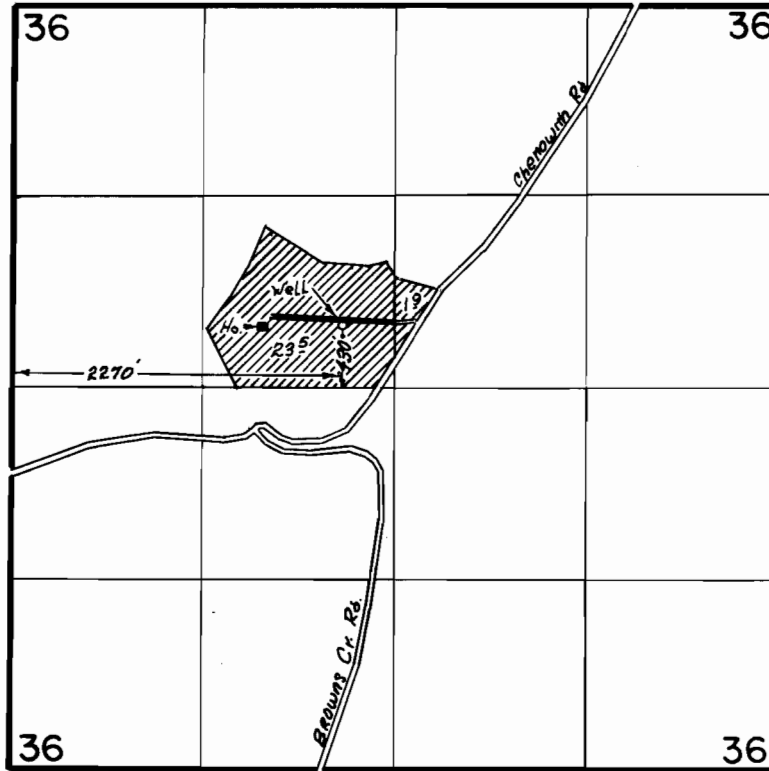

FINAL PROOF SURVEY
UNDER

Application No. G-6945 Permit No. G-6460
IN NAME OF

MARGARET K. & PAUL L. PATTON

Surveyed Jan. 13, 1983, by T. J. Paul