


T. 2 N., R. 12 E., W.M.

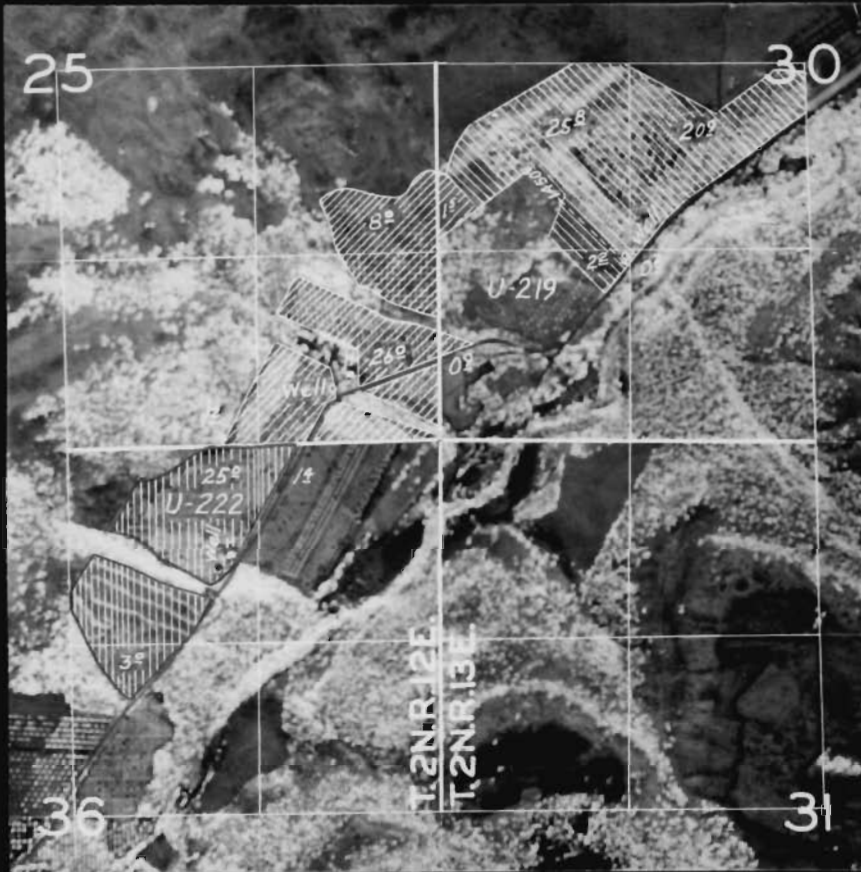

FINAL PROOF SURVEY

UNDER

U-222 U-204
Application No. U-219 Permit No. U-335

IN NAME OF

Henry Larick

Edward L. Weber

Surveyed June 2, 1954, by T. Jones

U-335-63