


T. 30 S., R. 15 W., W.M.

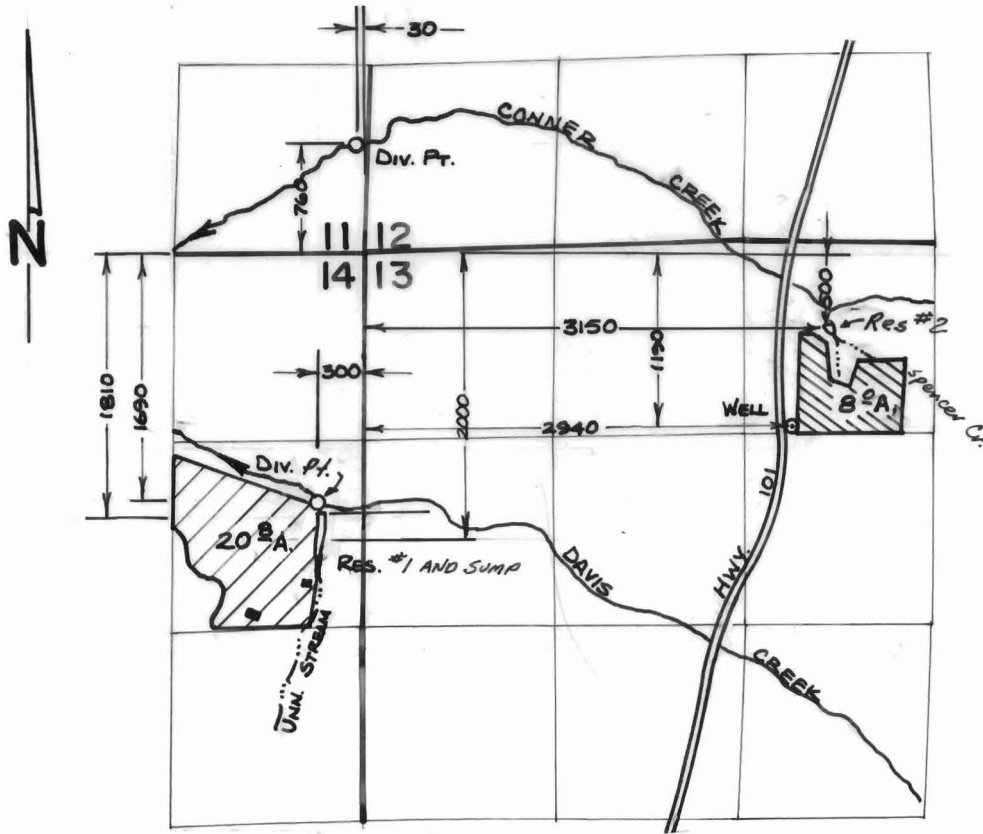

SCALE : 4" = 1 MILE

FINAL PROOF SURVEY UNDER

RG- 9494	RG- 9088		Sump
RG- 59563	RG- 8204		Reservoir
59564	45328		Unn. Stream & Reservoir
61157	46101		Davis Creek
RG- 11246	RG- 10489		Well
RG- 68151	RG- 10479		Spencer Creek Reservoir
68023	49345		Spencer Cr. & Res.
Application No. 68354	Permit No. 49429		Conner Creek

IN NAME OF

.....**HARRY G. SPENCER**.....

Surveyed 7/26 & 28, 19.88, by J.M. SCHMORDE.