


T. 15 S. R. 10 E. W.M.

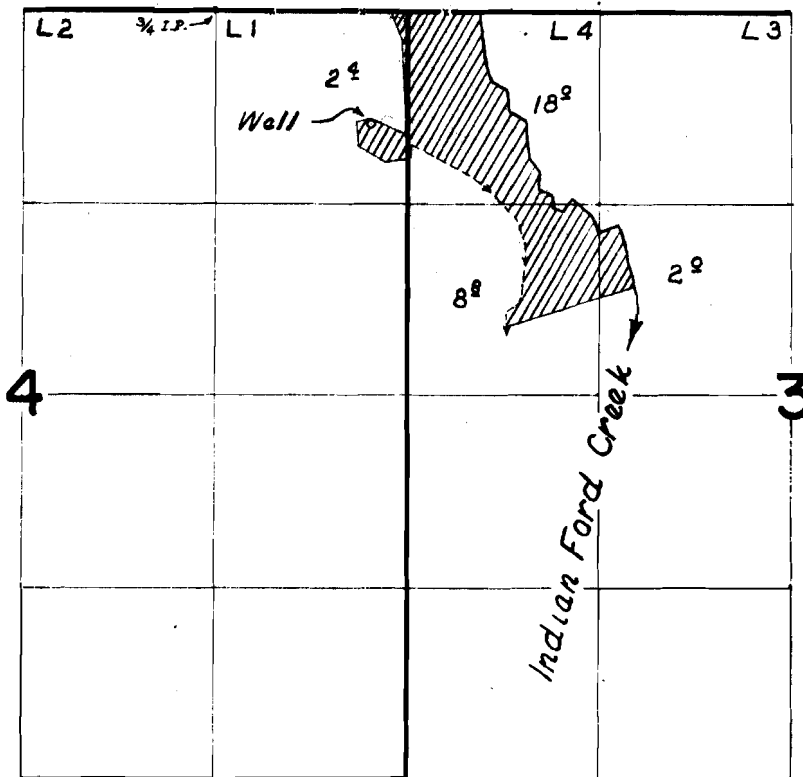

FINAL PROOF SURVEY UNDER

Application No. G-1425 Permit No. G-1300
IN NAME OF

H. D. BARCLAY

Surveyed Oct. 17, 1962, by T.R. Lauer

9-13-60