


T.5 S. R.1 E. W.M.

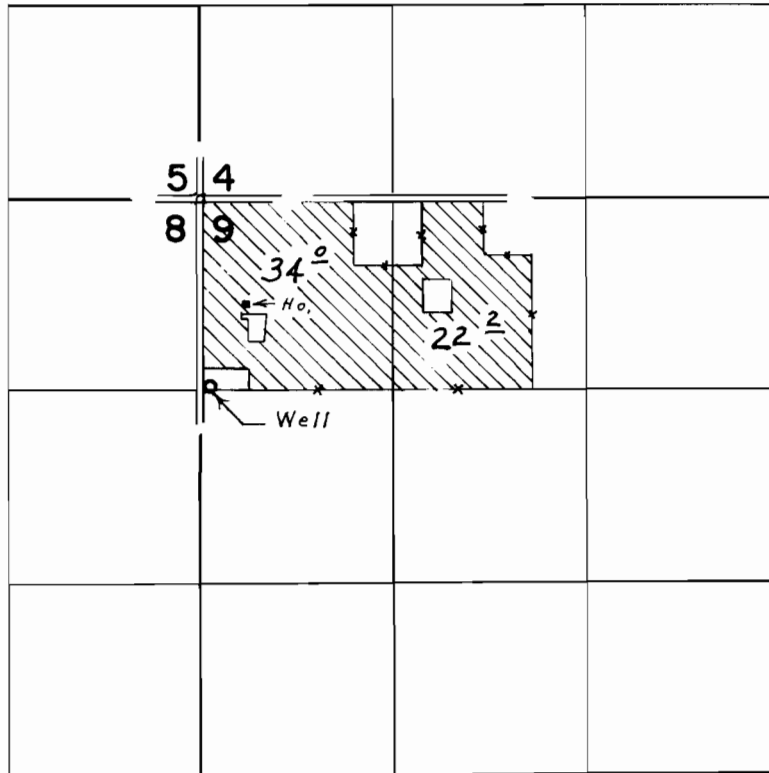

Well located 1300'S. & 70'E. from N.W. Corner Section 9

FINAL PROOF SURVEY UNDER

Application No. G-6618. Permit No. G-6197.
IN NAME OF

BILL L. ROSE

Surveyed April 1, 1976, by L. E. Gould