


6-4873


T.39S. R.11E. W.M.

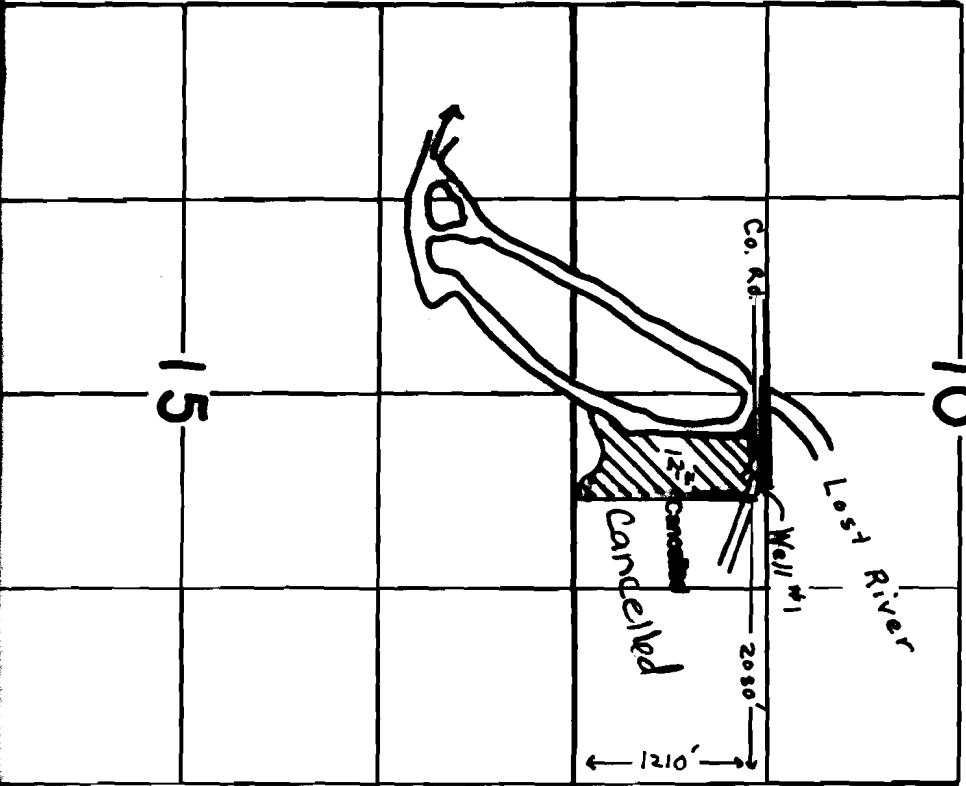

6-4873



6-4873

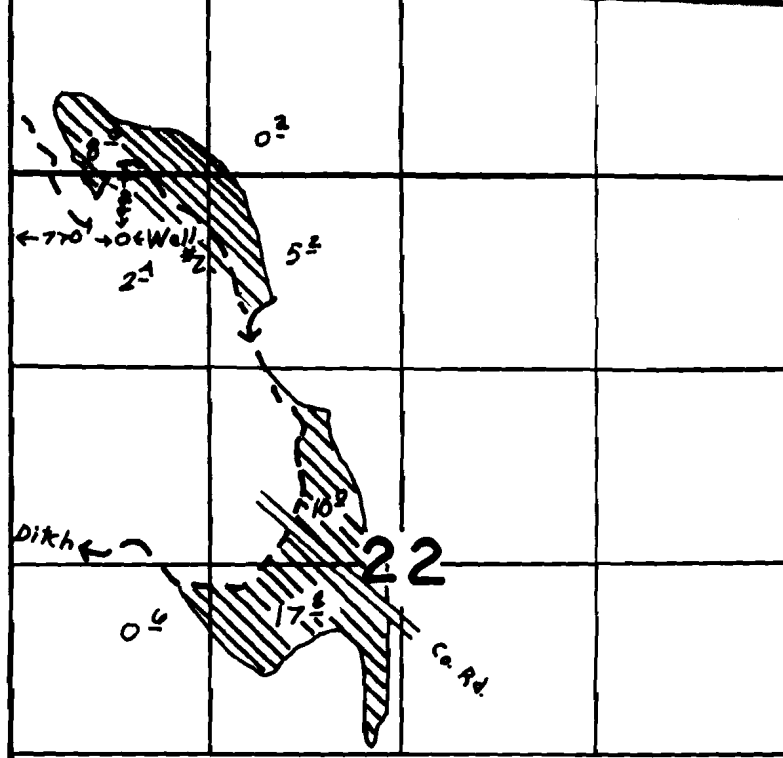

FINAL PROOF SURVEY

UNDER

Application No. G- 5140 Permit No. G-4873

IN NAME OF

FLYING DUTCHMEN LAND & CATTLE CO.

Surveyed Oct. 25, 1974, by L. E. Gould