


# T. 39 S., R. 11 E., W.M.

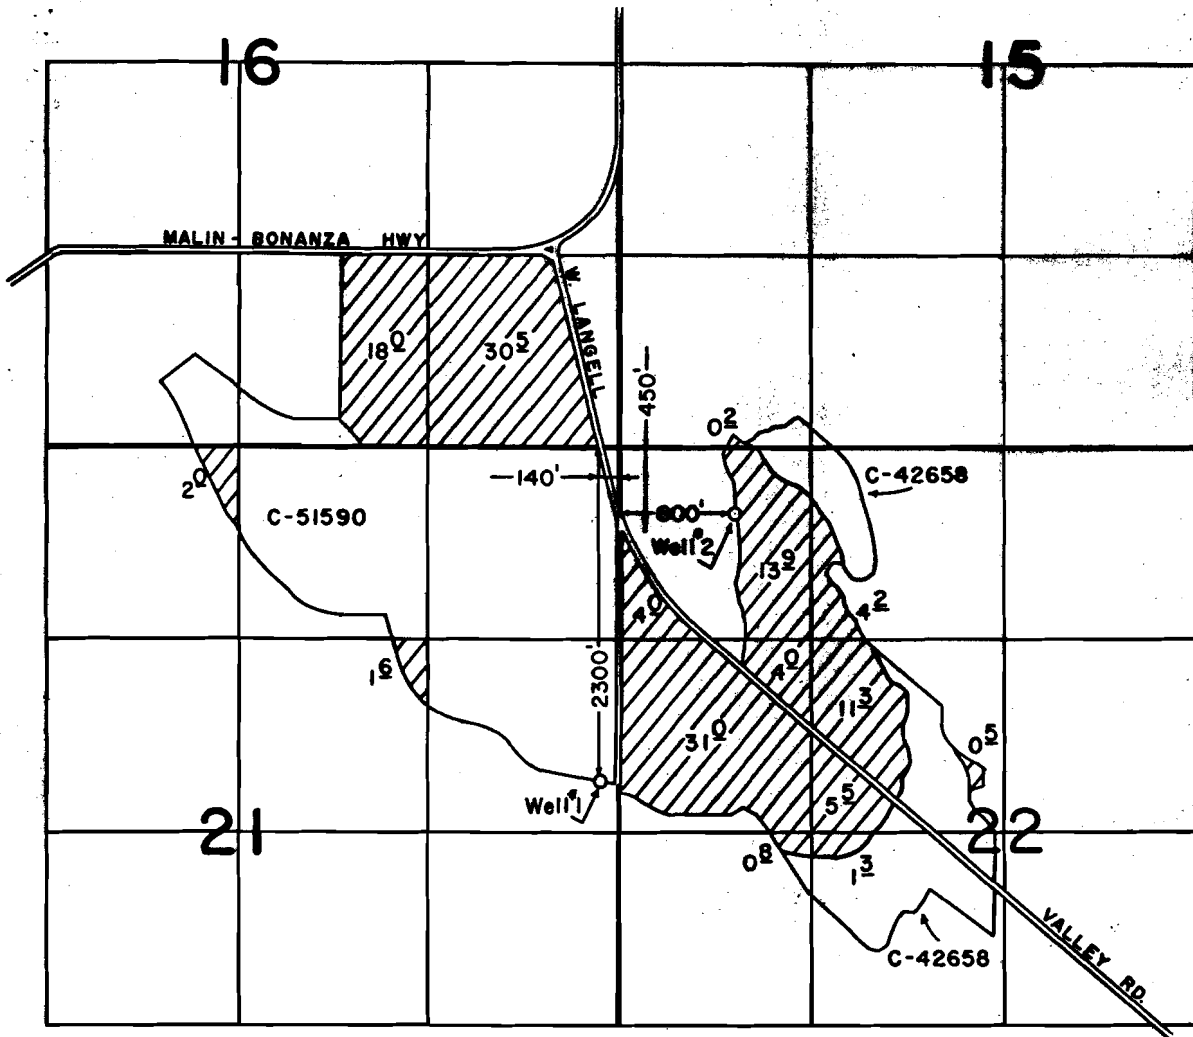

SCALE: 1" = 1320'

## FINAL PROOF SURVEY UNDER

Application No. G-10329 Permit No. G-9436.....  
IN NAME OF

**ARIE & ELSO DEJONG**

Surveyed SEPT. 13, 1989, by B. W. BISHOP.....