

T.36S.,R.2E.,W.M.


Jackson County, Oregon

Tax Lot No. 362E - 5310

MAP TO ACCOMPANY AN APPLICATION
FOR A WATER RIGHT TRANSFER
(CHANGE IN PLACE OF USE AND
ADDITIONAL POINT OF DIVERSION)

FOR: H.J. HANSCOM
and TERRY MATLOCK
P.O. BOX 2033
WHITE CITY, OR. 97503

PREPARED BY:
GARY D. KAISER
19440 HWY. 62
EAGLE POINT, OR. 97524
FEBRUARY 7, 2001
REVISED: MAY 30, 2001

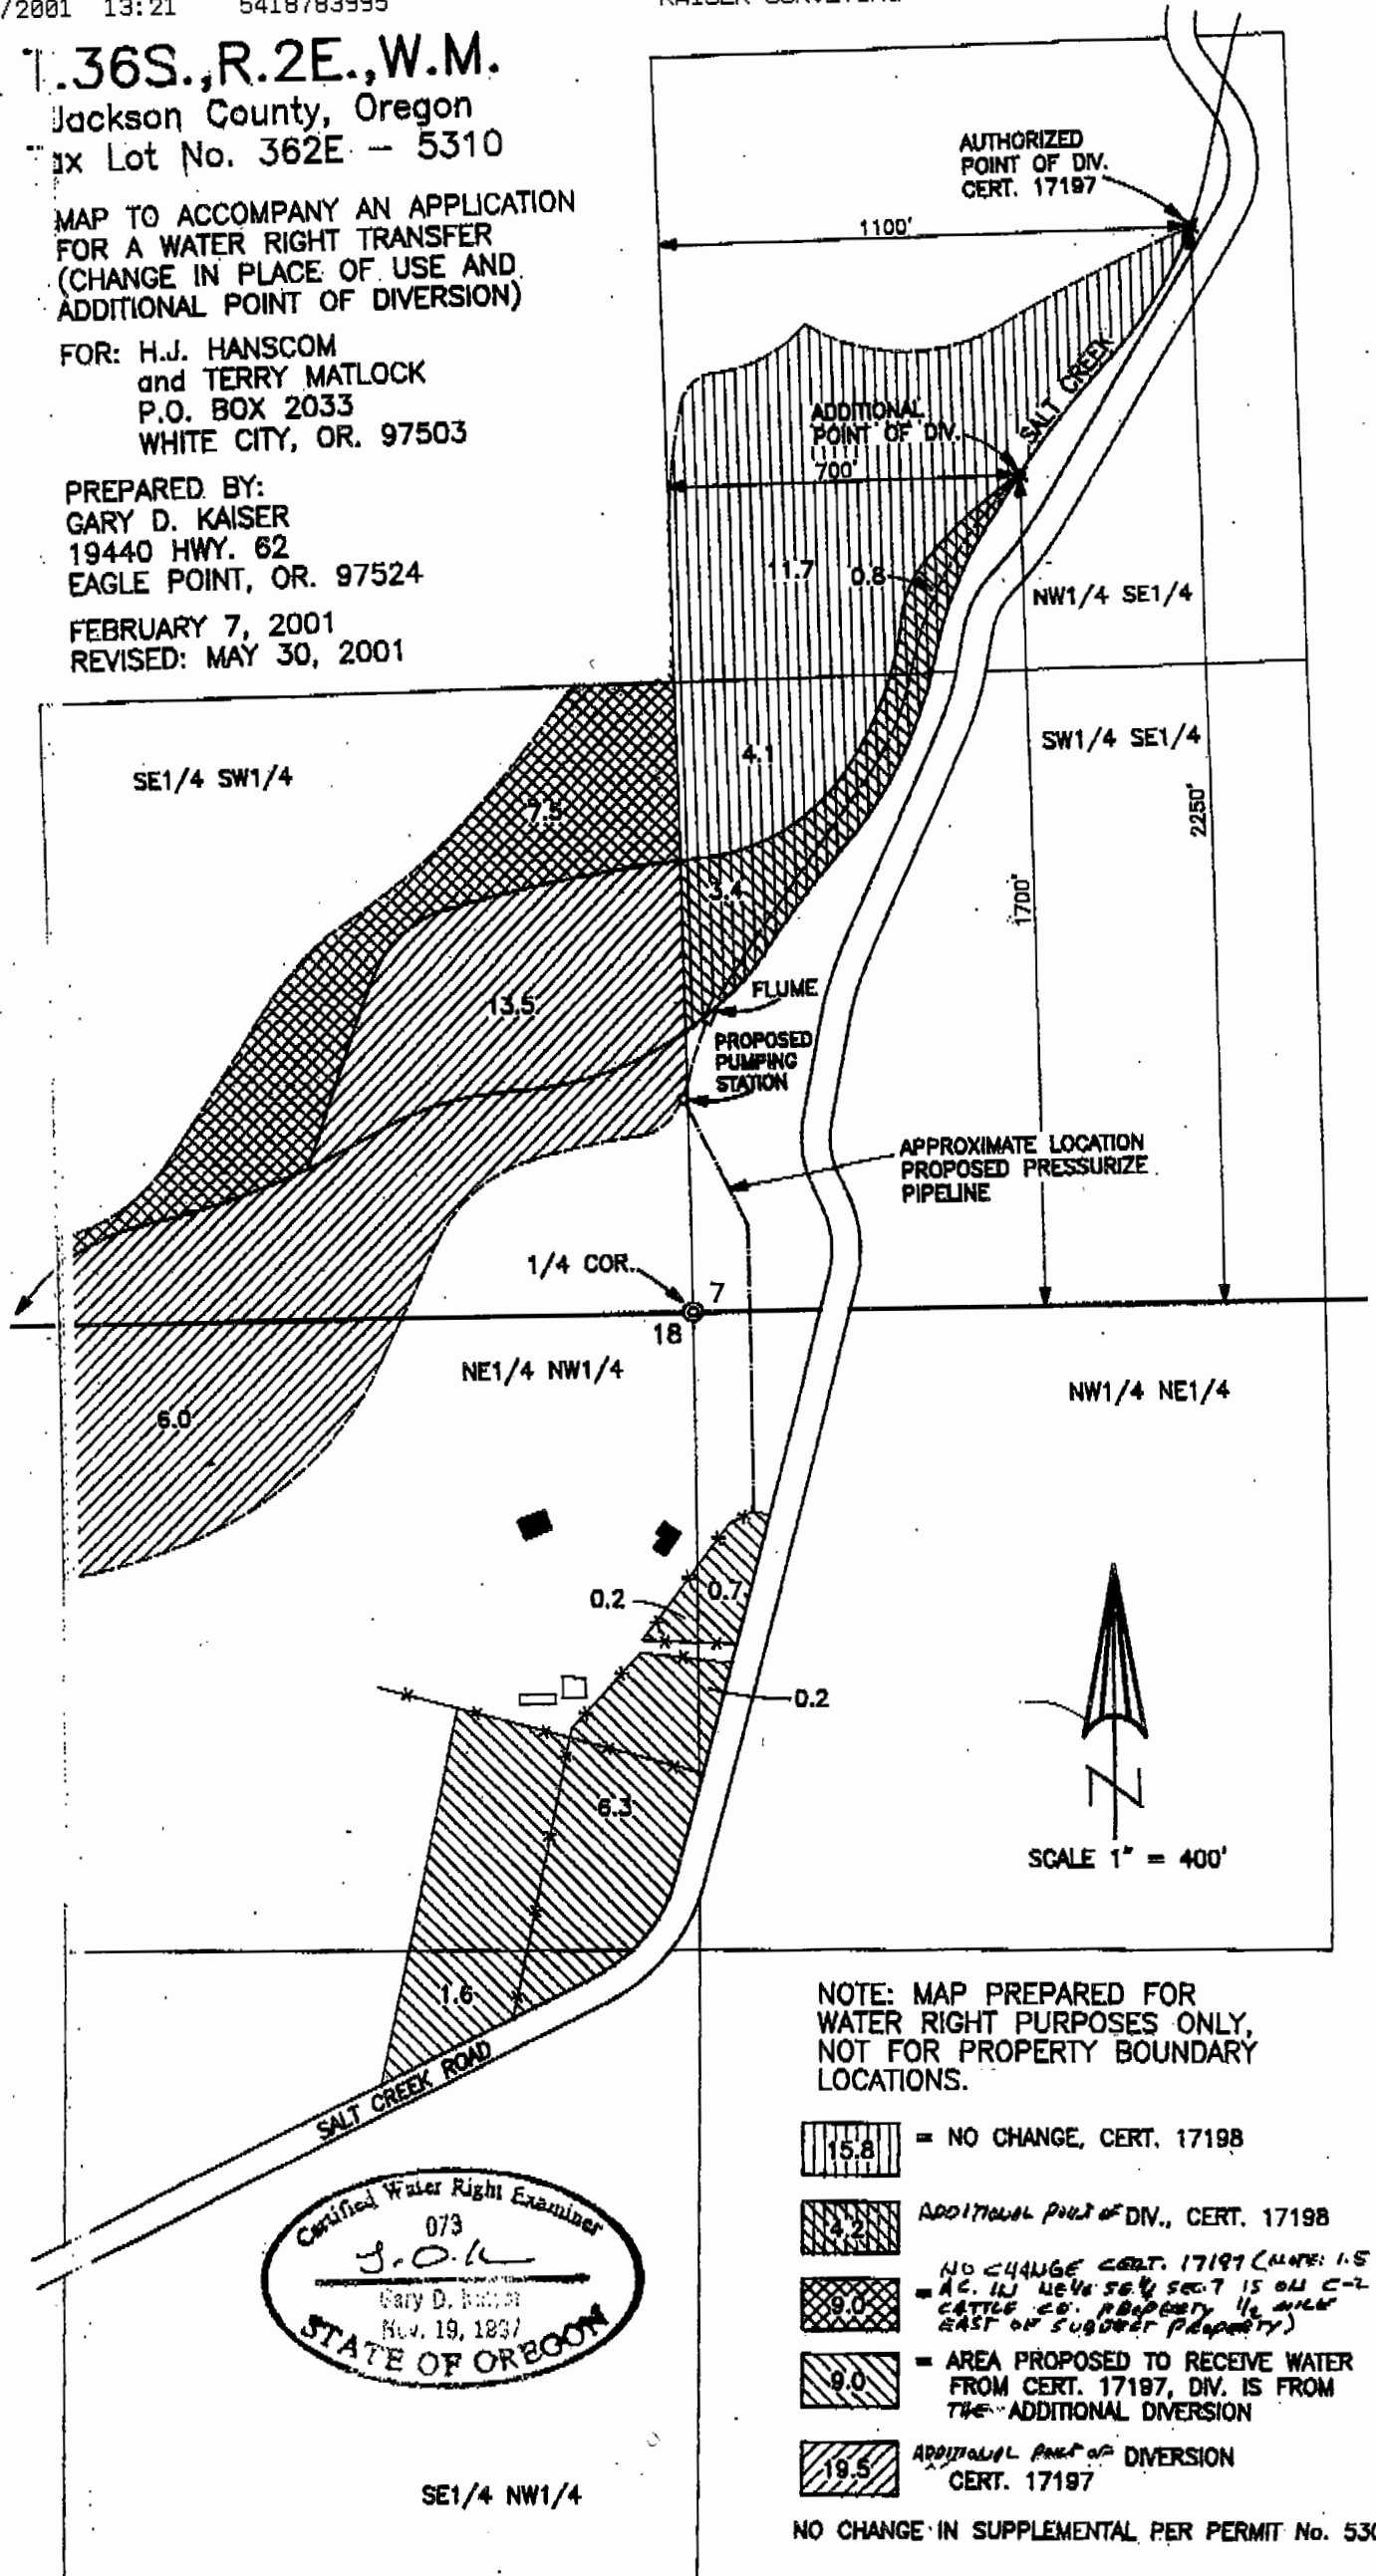

NOTE: MAP PREPARED FOR
WATER RIGHT PURPOSES ONLY,
NOT FOR PROPERTY BOUNDARY
LOCATIONS.

- 15.8 = NO CHANGE, CERT. 17198
- 4.2 ADDITIONAL POINT OF DIV., CERT. 17198
- NO CHANGE CERT. 17197 (NOTE: 1.5 AC. IN NE1/4 SE1/4 SEC. 7 IS ON C-2 CATTLE CO. PROPERTY 1/2 MILE EAST OF SUBJECT PROPERTY)
- 9.0 = AREA PROPOSED TO RECEIVE WATER FROM CERT. 17197, DIV. IS FROM THE ADDITIONAL DIVERSION
- 19.5 ADDITIONAL POINT OF DIVERSION CERT. 17197

NO CHANGE IN SUPPLEMENTAL PER PERMIT No. 53053