



T.36S., R.2E., W.M.

TAX LOT No. 362E - 5310

NOTE: MAP PREPARED FOR
WATER RIGHT PURPOSES ONLY,
NOT FOR PROPERTY BOUNDARY
LOCATIONS.

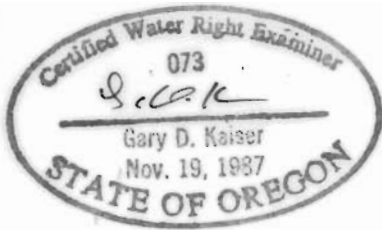

SCALE 1" = 400'

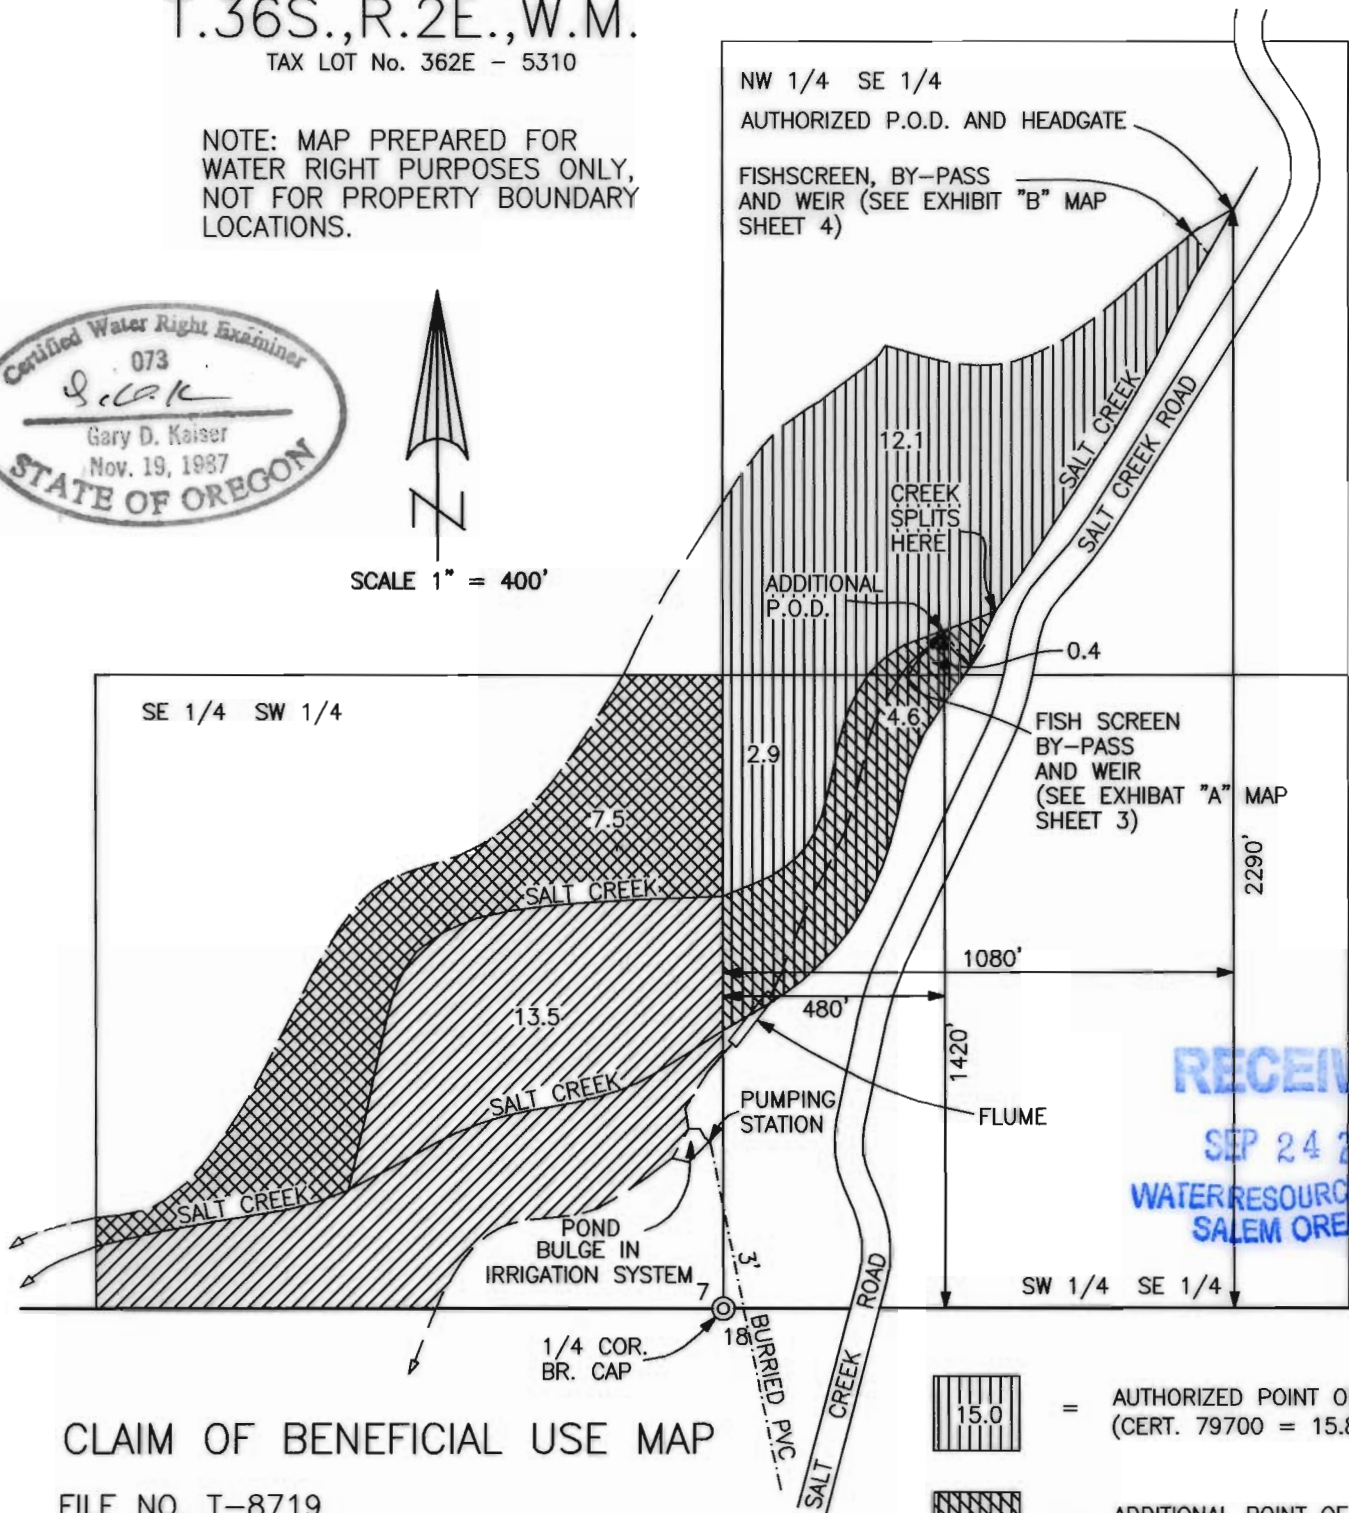

CLAIM OF BENEFICIAL USE MAP

FILE NO. T-8719

IN THE NAMES OF H.J. HANSCOM AND TERRY
MATLOCK
P.O. BOX 2033
WHITE CITY, OREGON 97503

MAP PREPARED SEPTEMBER 7, 2007
BY GARY D. KAISER



= AUTHORIZED POINT OF DIVERSION
(CERT. 79700 = 15.8 A.C.)



= ADDITIONAL POINT OF DIV.
(OLD CERT. 17198)



NO CHANGE CERT. 79701
= (NOTE: 1.5 AC. IN NE 1/4 SE 1/4
SEC. 7 IS ON C-2 CATTLE
CO. PROPERTY 1/2 MILE EAST
OF SUBJECT PROPERTY)



= ADDITIONAL POINT OF DIV.
(OLD CERT. 17197)

T.36S.,R.1E. & R.2E.,W.M.

Jackson County, Oregon
 Tax Lot No. 362E - 5310
 and 361E 13 - 100



SCALE 1" = 400'

MAP TO ACCOMPANY AN APPLICATION
 FOR A WATER RIGHT TRANSFER
 (CHANGE IN PLACE OF USE AND
 ADDITIONAL POINT OF DIVERSION)

FOR: H.J. HANSCOM
 and TERRY L. MATLOCK
 P.O. BOX 2033
 WHITE CITY, OR. 97503

PREPARED BY:
 GARY D. KAISER
 19440 HWY. 62
 EAGLE POINT, OR.
 97524

FEBRUARY 7, 2001
 REVISED: MAY 30, 2001

