


T. 22 S., R. 31 E., W. M.

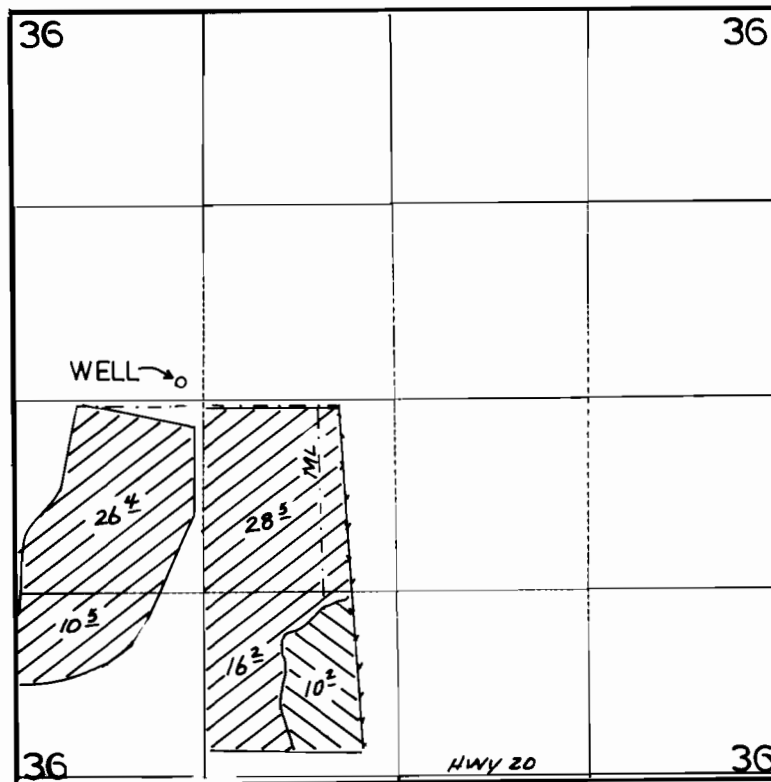

1" = 1320'

WELL - 110' N. & 1150' E. FROM THE W 1/4 COR., SEC. 36.



PRIMARY



Supp'l to Prather Creek
1884 Decreed Right V1, P50.

FINAL PROOF SURVEY UNDER

Application No. G-10604. Permit No. G-9900.....
IN NAME OF

Jack and Merilee Young

Surveyed ..5-13.... 1997., by J. MILLER.....
3-2-2000

RECEIVED

AT 3 0 2001

WATER RESOURCES DEPT
SALEM, OREGON

41025-279-172C

RECEIVED 10/10/92 SK