


T29S, R6W, WM


RECEIVED

SEP 30 1999

WATER RESOURCES DEPT
SALEM, OREGON

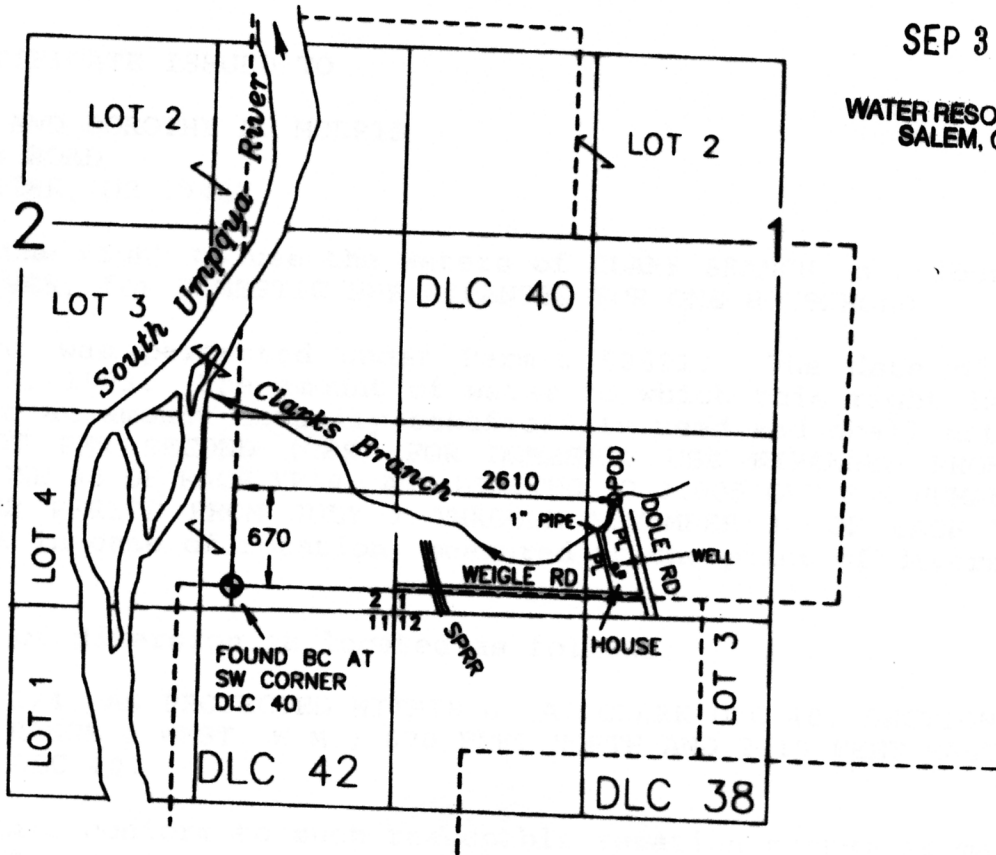

THIS MAP IS TO BE USED FOR WATER RIGHT PURPOSES ONLY

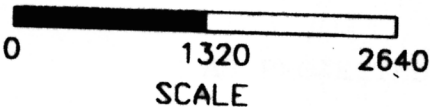


APPLICATION S-73222
PERMIT 52591

MAP TO ACCOMPANY CLAIM FOR BENEFICIAL USE
IN NAME OF

Clark C. Morris
Dorothy L. Morris

DATE September 25, 1999
BY: WILLIAM J. RUPPERT
P.O. BOX 1564
MYRTLE CREEK, OR 97457

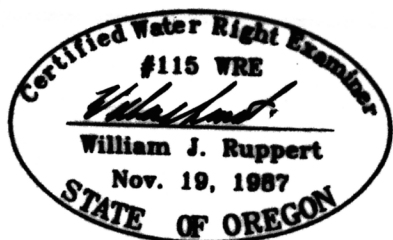

EXPIRES 12/31/2000