


Section 12 Township 23 S Range 10W W.M.
Douglas County

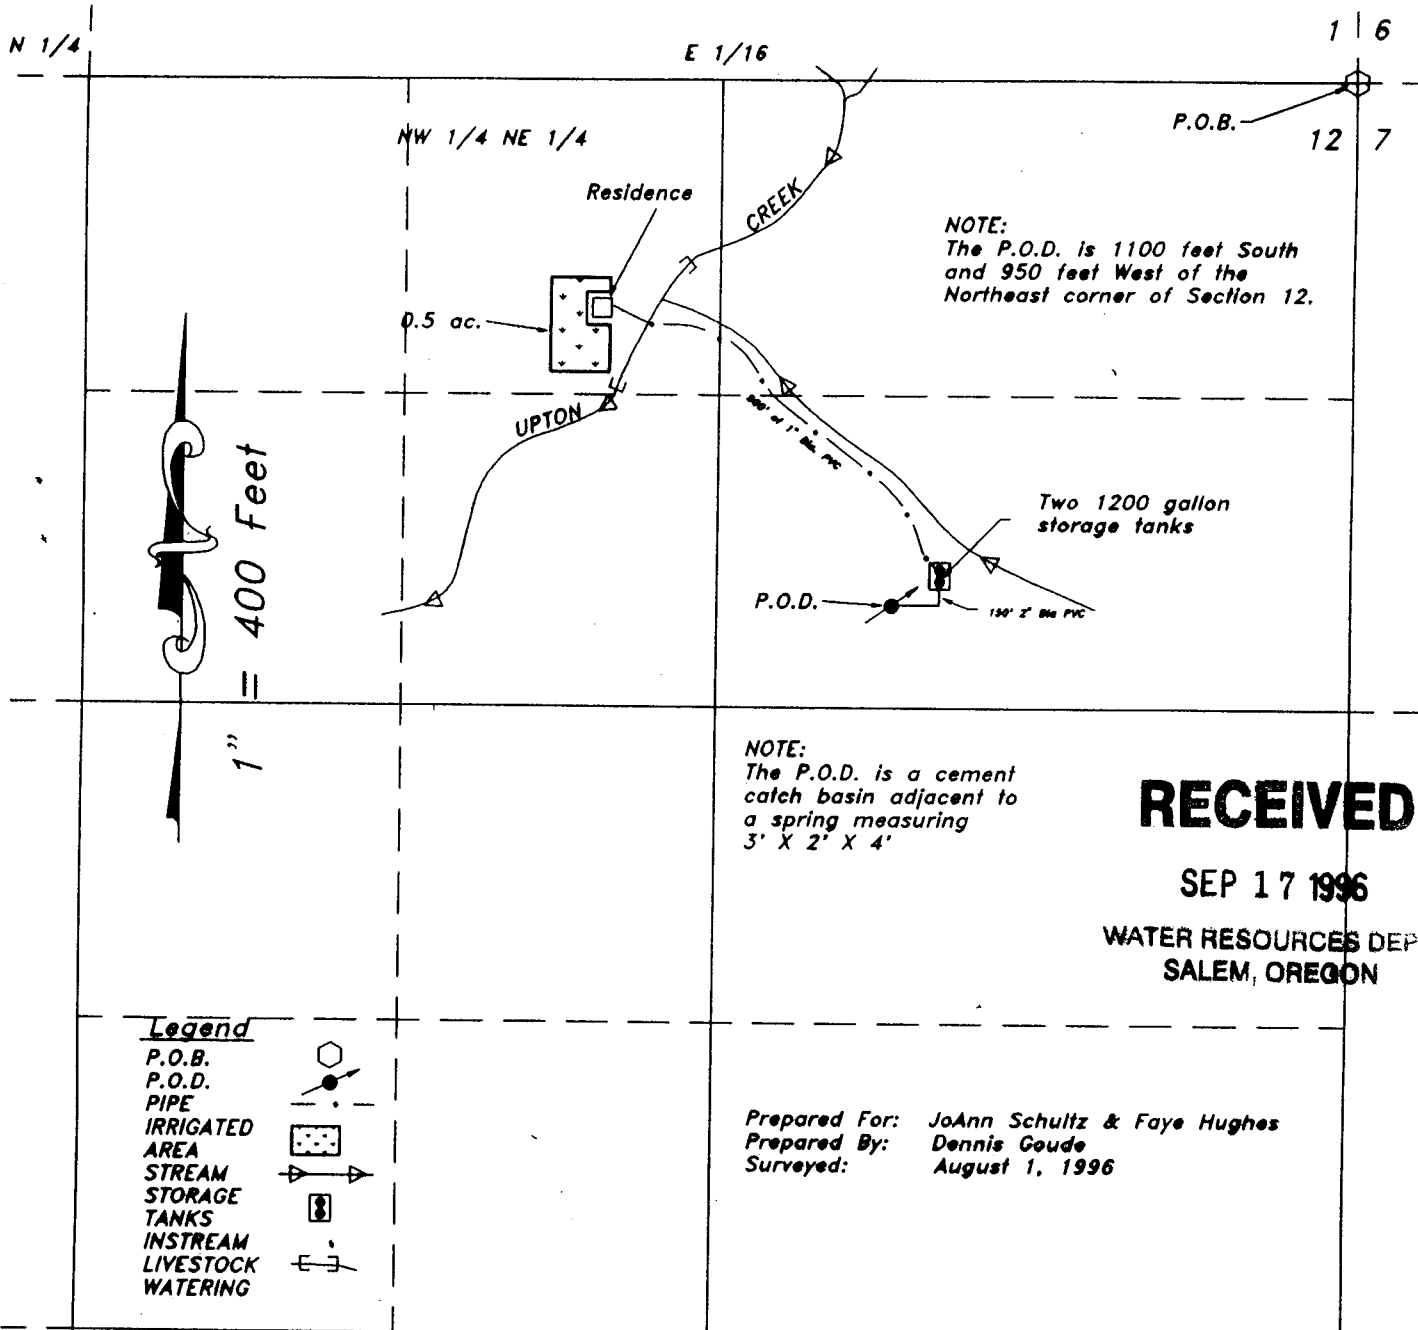

RECEIVED

SEP 17 1996

WATER RESOURCES DEPT.
SALEM, OREGON

Legend

P.O.B.
P.O.D.
PIPE
IRRIGATED AREA
STREAM
STORAGE TANKS
INSTREAM LIVESTOCK WATERING

Prepared For: JoAnn Schultz & Faye Hughes
Prepared By: Dennis Gaud
Surveyed: August 1, 1996

EXAMINERS DISCLAIMER STATEMENT

NOTE:


The P.O.D. and Waterline is entirely located on property owned by the applicant.

The preparation of this map was for the purpose of identifying the location of the Water Right only and has no intent to provide dimensions or location of property ownership lines.

FINAL PROOF SURVEY
IN THE NAME OF

JoAnn Schultz & Faye Hughes

Surveyed on Aug. 1, 1996 by K.D. Olson

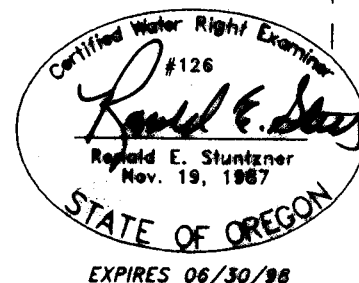

Application No. S-74063
Permit No. 51603