

RECEIVED


SEP 08 2000

WATER RESOURCES DEPT.
SALEM, OREGON

T24S, R6W, WM

DOUGLAS COUNTY

SCALE 1" = 1320'

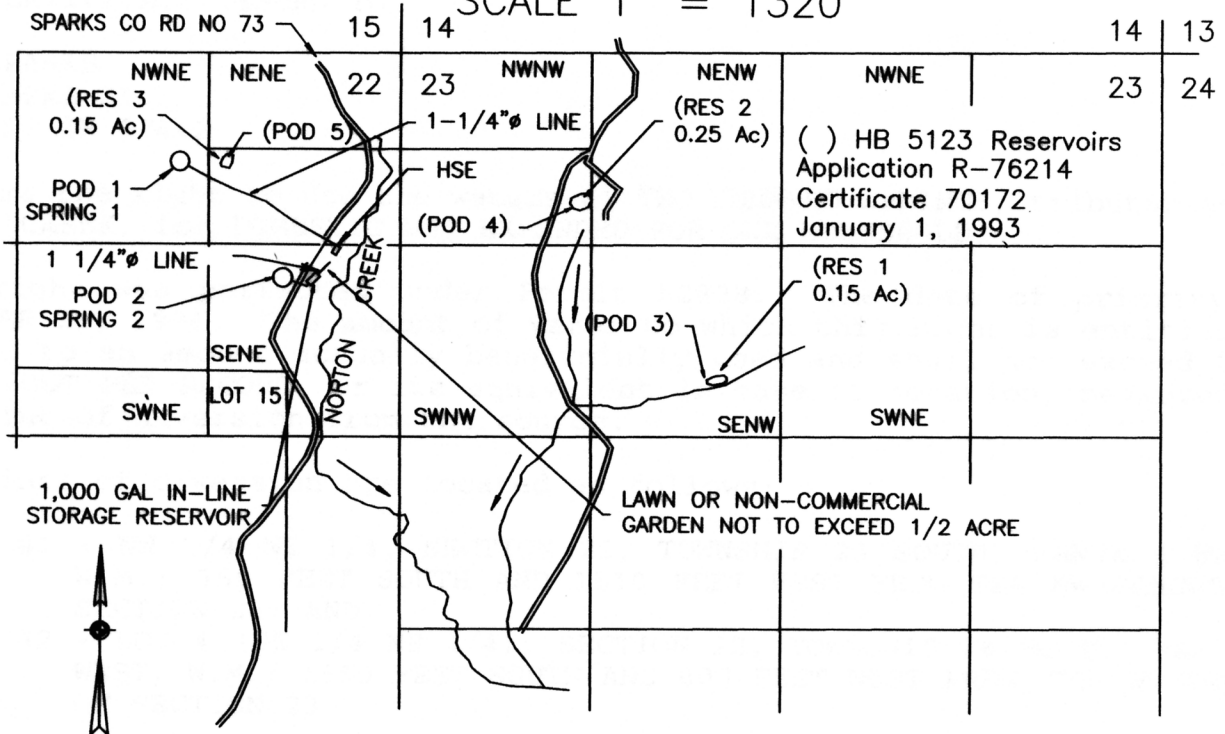

POD 1 IS 760 FT S AND 1510 FT W FROM NW COR SEC 23
POD 2 IS 1560 FT S AND 800 FT W FROM NW COR SEC 23
(POD 3 IS 2240 FT S AND 2160 FT E FROM NW COR SEC 23)
(POD 4 IS 1050 FT S AND 1180 FT E FROM NW COR SEC 23)
(POD 5 IS 710 FT S AND 1150 FT W FROM NW COR SEC 23)

FINAL PROOF SURVEY
UNDER

ELLA SPARKS
839 SPARKS ROAD
OAKLAND, OR 97462


Application No. S-76213 Permit No. 52898

IN NAME OF
ELLA SPARKS

MAURICE E FARR
WATER RIGHT EXAMINER
395 NE KIRBY AVENUE
ROSEBURG, OR 97470

Surveyed August 15, 2000 by M.E. Farr

THIS IS A LOCATION MAP FOR A FINAL PROOF SURVEY BY ELLA SPARKS. THIS MAP IS FOR THE PURPOSE OF IDENTIFYING THE LOCATION OF THE WATER RIGHT ONLY AND IS NOT INTENDED TO PROVIDE LEGAL DIMENSIONS OR LOCATIONS OF PROPERTY OWNERSHIP LINES.

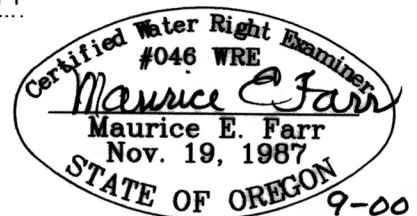

EXPIRES 12-31-01